

Wayne  
G 105  
8-16-72

MISSISSIPPI  
BOARD OF WATER COMMISSIONERS  
416 North State Street  
Jackson, Mississippi 39201

WATER WELL DRILLERS LOG

**CODED**

Aug 16 1972 Porter Drilling & Log Wayne  
date well completed firm name county well located

LANDOWNER: Greta Lee  
Standard  
Box 1 Shubuta Miss.  
(mailing address)

description of formations encountered	from	to
<u>sand &amp; chalk</u>	<u>0</u>	<u>44</u>
<u>rock strata</u>	<u>44</u>	<u>57</u>
<u>green chalk</u>	<u>57</u>	<u>98</u>
<u>Flintstone rock</u>	<u>98</u>	<u>102</u>

WELL LOCATION:  
sec. 4 T. 90 N. R. 2 E. S. 10 W.  
10 miles NW of Waynesboro  
(distance) (direction) (nearest town)

WELL PURPOSE: None  
(home, irrigation, municipal, industrial)

- WELL COMPLETION DATA:
- (1) diameter (inches) 2"
  - (2) total depth (feet) 122'
  - (3) static water level (feet) 34' below top of ground.
  - (4) casing steel 98'  
(material) (depth)  
2' If telescope see back.  
(size)
  - (5) screen none used  
(length) (depth to top)  
(size) (material)
  - (6) pump 1 10  
(HP) (yield gpm)  
elec  
(type power)
  - (7) electric log no  
(yes or no)
  - (organization running log)
  - (8) how well bottom plugged open

DRILLERS REMARKS:

42' 1/4" drop pipe


**CODED**

SEP 19 1972  
SEP 20 1972

MISS. BD. OF  
WATER COMMISSIONERS

If well telescopes please sketch and show depths.

GROUND LEVEL

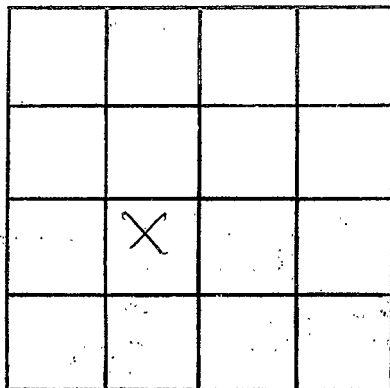

SECTION 4

Please indicate well location X!

ADDITIONAL INFORMATION

If more than one screen,  
show locations of each on sketch.