

MISSISSIPPI  
BOARD OF WATER COMMISSIONERS  
416 North State Street  
Jackson, Mississippi 39201

**CODED**

WATER WELL DRILLERS LOG

WAYNE  
G106  
9-11-72

Sept 11 1972 Ray W Westlake Wayne  
date well completed firm name county well located

LANDOWNER: <u>James J. Hinton</u>	description of formations encountered	from	to
<u>Rt 1 Waynesboro</u>			
(mailing address)	<u>Sandy clay</u>	<u>0</u>	<u>15</u>
	<u>Clay</u>	<u>15</u>	<u>60</u>
	<u>Sandy Clay</u>	<u>60</u>	<u>75</u>
	<u>Sand</u>	<u>75</u>	<u>103</u>

WELL LOCATION:  
sec. 33 T 9 N R 8 E  
18 miles E of Louel  
(distance) (direction) (nearest town)

WELL PURPOSE: home  
(home, irrigation, municipal, industrial)

- WELL COMPLETION DATA:
- (1) diameter (inches) 2
  - (2) total depth (feet) 103
  - (3) static water level (feet) 65 <sup>below</sup> / above top of ground.
  - (4) casing plastic ~~88~~ 88  
(material) (depth)
  - (size) 5 88  
(length) (depth to top)
  - (5) screen 14 St Steel  
(size) (material)
  - (6) pump 1 8  
(HP) (yield gpm)
  - RE-A  
(type power)
  - (7) electric log no  
(yes or no)
  - (organization running log)
  - (8) how well bottom plugged was done

**CODED**


OCT 12 1972

DRILLERS REMARKS:

LIBRARY

If well telescopes please sketch and show depths.

GROUND LEVEL

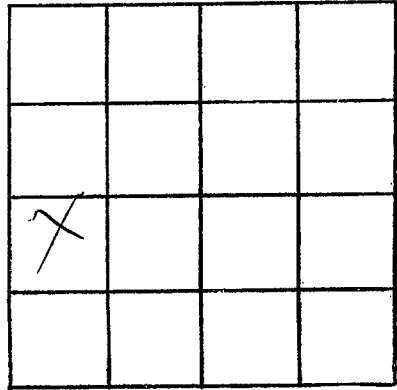

SECTION 33

Please indicate well location X.

ADDITIONAL INFORMATION

If more than one screen, show locations of each on sketch.