

Wayne
G 107
11-17-72

MISSISSIPPI
BOARD OF WATER COMMISSIONERS
416 North State Street
Jackson, Mississippi 39201

CODED

WATER WELL DRILLERS LOG

Nov 17, 1972 date well completed
McILWAIN WATER WELL SER firm name
Wayne county well located

LANDOWNER:
ALTON CARR
Rt 1, WAYNESBORO, MISS
(mailing address)

WELL LOCATION:
sec. 35 T 9 N R 8 E
7 miles W of W'BORO
(distance) (direction) (nearest town)

WELL PURPOSE: HOME
(home, irrigation, municipal, industrial)

- WELL COMPLETION DATA:
- (1) diameter (inches) 2"
 - (2) total depth (feet) 104'
 - (3) static water level (feet) 70' below top of ground.
 - (4) casing PVC, 100' (material) (depth)
2" (size) If telescope see back.
 - (5) screen 5' 99' (length) (depth to top)
2" PVC .008 (size) (material)
 - (6) pump 1 7.5 (HP) (yield gpm)
220 AC (type power)
 - (7) electric log NO (yes or no)
 - (organization running log)
 - (8) how well bottom plugged

description of formations encountered	from	to
Red Clay	0	8
Clay	8	12
Fine sand	12	70
Clay	70	78
Fine sand	78	85
Clay	85	88
Coarse sand, gravel + sand rock	88	104


CODED

DRILLERS REMARKS:

DEC 11 1972

If well telescopes please sketch and show depths.

GROUND LEVEL

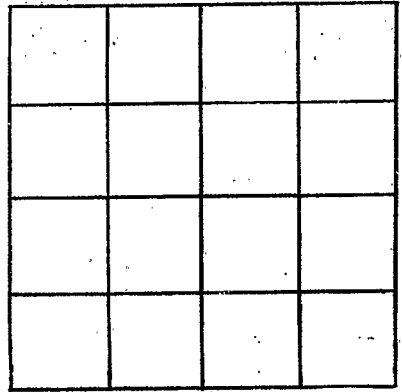

SECTION _____

Please indicate well location X.

ADDITIONAL INFORMATION

more than one screen,
w locations of each on sketch.