

**MISSISSIPPI
BOARD OF WATER COMMISSIONERS**
416 North State Street
Jackson, Mississippi 39201

CODED

WAYNE

G108

4-9-73

WATER WELL DRILLERS LOG

April 9 1973
date well completed

Bohrer Drilling Co.
firm name

Wayne
county well located


LANDOWNER	Description of formations encountered	from	to
Luther Williams			
At 1 Lubata Miss (mailing address)	vert. clay sand & gravel	0	30
WELL LOCATION: sec. <u>17</u> T <u>9</u> N R <u>8</u> E <u>9</u> miles NW of <u>Waynesboro</u> (distance) (direction) (nearest town)	gravel shaly shale filled in sand	30	40
WELL PURPOSE: (home, irrigation, municipal, industrial)			
WELL COMPLETION DATA: (1) diameter (inches) <u>2"</u> (2) total depth (feet) <u>50'</u> (3) static water level (feet) <u>32</u> (below/above top of ground) (4) casing <u>steel</u> <u>44'</u> (material) (depth) <u>2"</u> If telescope see back. (size) (5) screen <u>5'</u> <u>45'</u> (length) (depth to top) <u>1/4"</u> <u>6-in. SS.</u> (size) (material) (6) pump <u>1/2</u> <u>7</u> (HP) (yield gpm) <u>elec.</u> (type power) (7) electric log <u>no</u> (yes or no) (organization running log)	39' 1 1/2" clay gravel 5' 1 1/2" gravel SS with 2" 1/4" gravel in with gravel		
DRILLERS REMARKS: <u>flush joint</u>			

CODED

MAY 1 1973

If well telescopes please sketch and show depths.

GROUND LEVEL

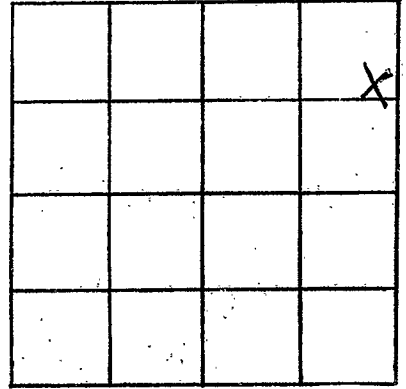

SECTION 12

Please indicate well location X.

ADDITIONAL INFORMATION

If more than one screen,
show locations of each on sketch.