

WAYNE

G 109

4-2-73

MISSISSIPPI
 BOARD OF WATER COMMISSIONERS
 416 North State Street
 Jackson, Mississippi 39201

WATER WELL DRILLERS LOG

CODED

April 2 1973 *Boyer Drilling & Log* Wayne
 date well completed firm name county well located

LANDOWNER: *V.P. Watts*

description of formations encountered	from	to
---------------------------------------	------	----

At 3 Magneshorn Miss
 (mailing address)

<i>red clay</i>	0	30
<i>Blue chalk</i>	30	90
<i>Coarse red sand</i>		
<i>Open gravel</i>	90	144
<i>Thin shell rubble</i>		
<i>shell in sand</i>		

WELL LOCATION:
 sec 35 T 9 N S R 8 E W
7 miles W of Magneshorn
 (distance) (direction) (nearest town)

WELL PURPOSE: Home
 (home, irrigation, municipal, industrial)

WELL COMPLETION DATA:

- (1) diameter (inches) 2"
- (2) total depth (feet) 144
- (3) static water level (feet) 73 ^{below} _{above} top of ground.
- (4) casing steel 140'
 (material) (depth)
2' if telescope see back.
 (size)
- (5) screen 3' 141
 (length) (depth to top)
1/4 schl ss.
 (size) (material)
- (6) pump 1 8
 (HP) (yield gpm)
elec.
 (type power)
- (7) electric log no
 (yes or no)

84' 1/4" drop pipe
3' 1/4" schl ss
with 2' 1/4" drop
section in milk tanker

CODED

MAY 2 1973

(organization running log)


(8) how well bottom plugged
flush point

DRILLERS REMARKS:

MISSISSIPPI BOARD OF WATER COMMISSIONERS

If well telescopes please sketch and show depths.

GROUND LEVEL

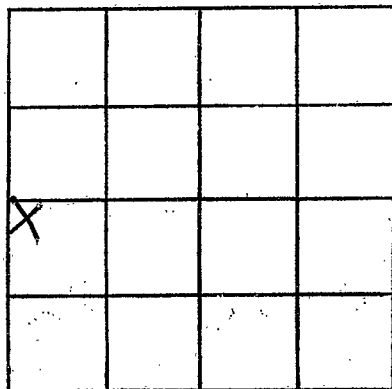

SECTION 35

Please indicate well location X.

ADDITIONAL INFORMATION

If more than one screen,
show locations of each on sketch.