

WAYNE
G 110
4-2-73

MISSISSIPPI
BOARD OF WATER COMMISSIONERS
416 North State Street
Jackson, Mississippi 39201

CODED

WATER WELL DRILLERS LOG

April 2 1973 Boyle Drilling Inc Wayne
date well completed firm name county well located


LANDOWNER: <u>Willy Miller</u>	description of formations encountered	from	to
<u>At 121 Amesbury, Mer</u> (mailing address)	<u>sand & gravel</u>	<u>0</u>	<u>60</u>
	<u>blue chalk</u>	<u>60</u>	<u>95</u>
	<u>blue chalk</u>	<u>95</u>	<u>120</u>
	<u>red shales</u>	<u>120</u>	<u>140</u>
	<u>blue chalk</u>	<u>140</u>	<u>180</u>
	<u>red shales</u>	<u>180</u>	<u>210</u>
WELL LOCATION: sec <u>24</u> T <u>9</u> N R <u>8</u> E W <u>6</u> miles <u>NW</u> of <u>Waynesboro</u> (distance) (direction) (nearest town)			
WELL PURPOSE: <u>home</u> (home, irrigation, municipal, industrial)			
WELL COMPLETION DATA: (1) diameter (inches) <u>2"</u> (2) total depth (feet) <u>210</u> (3) static water level (feet) <u>110</u> (below/above top of ground) (4) casing <u>steel</u> , <u>180'</u> (material) (depth) <u>2"</u> If telescope see back. (size) (5) screen <u>none</u> , <u>used</u> (length) (depth to top) (size) (material) (6) pump <u>2</u> , <u>5</u> (HP) (yield gpm) <u>elec.</u> (type power) (7) electric log <u>no</u> (yes or no) (organization running log) (8) how well bottom plugged <u>open</u>	<u>147'</u> <u>1 1/2" drop pipe</u>		
DRILLERS REMARKS:			

CODED

WAY 1 19/73

If well telescopes please sketch and show depths.

GROUND LEVEL

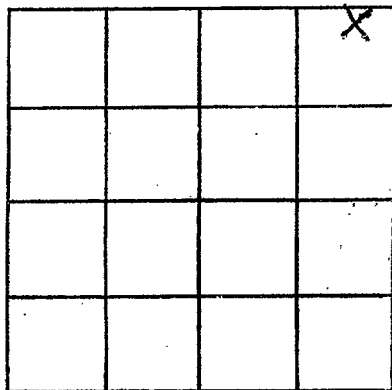

SECTION 24

Please indicate well location X.

ADDITIONAL INFORMATION

If more than one screen,
show locations of each on sketch.