

WAYNE
G 114
8-20-73

BOARD OF WATER COMMISSIONERS
416 North State Street
Jackson, Mississippi 39201

SEP 12 1973

WATER WELL DRILLERS LOGGED

MISS. BD. OF
WATER COMM.

Aug 20 1973 date well completed
Booth Drilling & Log firm name
Wayne county well located

LANDOWNER: Hardie (Seymour)

description of formations encountered

from to

Rt 1 Phulula
(mailing address)

Clay & sand	0	26
Coarse sand & chalk	26	50
Chalk	50	75
sand	75	81
Chalk	81	83
rock strata	83	89
blue chalk	89	105
rock strata	105	112
blue chalk	112	150
Wachaburg	150	181

WELL LOCATION:

sec. 6 T. 9 N. R. 8 E.
3 miles SE of Emattin
(distance) (direction) (nearest town)

WELL PURPOSE: Home
(home, irrigation, municipal, industrial)

WELL COMPLETION DATA:


- (1) diameter (inches) 2"
- (2) total depth (feet) 181'
- (3) static water level (feet) 20' ^(below) _(above) top of ground.
- (4) casing steel, 1.51'
(material) (depth)
2" if telescope see back.
(size)
- (5) screen none, wood
(length) (depth to top)
(size) (material)
- (6) pump 1/2 2 1/2
(HP) (yield gpm)
elec.
(type power)
- (7) electric log not
(yes or no)
(organization running log)
- (8) how well bottom plugged open

105' 1 1/4" diameter
CODED

DRILLERS REMARKS:

If well telescopes please sketch and show depths.

GROUND LEVEL

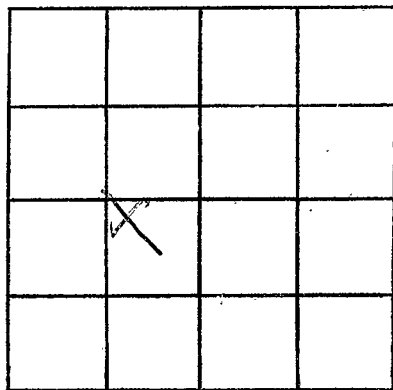

SECTION 6

Please indicate well location X.

ADDITIONAL INFORMATION

If more than one screen,
show locations of each on sketch.