

WAYNE
G 115
8-28-73

MISSISSIPPI
BOARD OF WATER COMMISSIONERS
416 North State Street
Jackson, Mississippi 39201

SEP 12 1973


WATER WELL DRILLERS LOG CODED. OF

Aug 28 1973 date well completed
 World Drilling & Log firm name
 WATER COMM. 27 county well located

LANDOWNER: <u>Harry Barnett</u>	description of formations encountered	from to
<u>Box 1 Shubuta Miss</u> (mailing address)	<u>rest of clay</u>	<u>0 8</u>
WELL LOCATION: sec. <u>15</u> T. <u>90</u> N. R. <u>8</u> E. <u>8</u> miles <u>NW</u> of <u>Waynesboro</u> (distance) (direction) (nearest town)	<u>chalk & sand</u>	<u>3 11.4</u>
WELL PURPOSE: <u>Home</u> (home, irrigation, municipal, industrial)	<u>rock strata</u>	<u>25 96</u>
WELL COMPLETION DATA: (1) diameter (inches) <u>2"</u>	<u>blue chalk</u>	<u>76 111</u>
(2) total depth (feet) <u>166</u>	<u>Trachelony</u>	<u>141 166</u>
(3) static water level (feet) <u>63</u> <u>below</u> top of ground.	<u>8 1/2" 1 1/4" clay pipe</u>	<u>11 0 0</u>
(4) casing <u>steel</u> ; <u>141</u> (material) (depth) <u>2"</u> (size) if telescope see back.	CODED	
(5) screen <u>none, used</u> (length) (depth to top) (size) (material)		
(6) pump <u>1</u> (HP) <u>8</u> (yield gpm) <u>elec.</u> (type power)		
(7) electric log <u>no</u> (yes or no) (organization running log)		
(8) how well bottom plugged <u>open</u>		
DRILLERS REMARKS:		

If well telescopes please sketch and show depths.

GROUND LEVEL

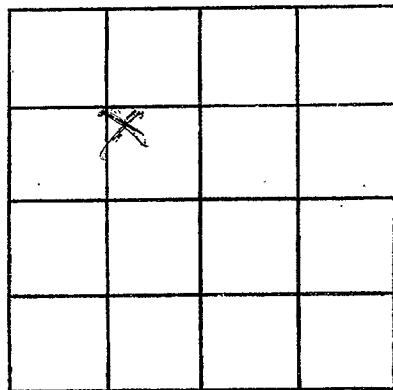

SECTION 15

Please indicate well location X.

ADDITIONAL INFORMATION

If more than one screen,
show locations of each on sketch.