

WAYNE
G 116
8-16-73

MISSISSIPPI
BOARD OF WATER COMMISSIONERS
416 North State Street
Jackson, Mississippi 39201

SEP 12 1973

CODED

WATER WELL DRILLERS LOG

MISS. BD. OF
WATER COMM.

Aug 11, 1973 Robert Driller's & Son W. Adams
date well completed firm name county well located

LANDOWNER: Jimmy Lee
Samson

description of formations
encountered

from

to

At 1 Shubuta Miss
(mailing address)

red clay	0	18
blue chert	18	46
thin rock		116
blue chert	46	61
sand	61	65
chert	65	75
rock strata	75	85
blue chert	85	131
Uicksburg	131	157

WELL LOCATION:

sec. 9 T. 9 (N) R. 8 (E)
S (W)
9 miles NW of Haynes
(distance) (direction) (nearest town)

WELL PURPOSE: home
(home, irrigation, municipal, industrial)

WELL COMPLETION DATA:


- (1) diameter (inches) 2"
- (2) total depth (feet) 157
- (3) static water level (feet) 61 (below above top of ground.)
- (4) casing steel, 134,
(material) (depth)
2'
(size) If telescope see back.
- (5) screen none used
(length) (depth to top)
(size) (material)
- (6) pump 1, 8 1/2
(HP) (yield gpm)
elec.
(type power)
- (7) electric log no
(yes or no)
(organization running log)
- (8) how well bottom plugged open

84 CODED drop pipe

DRILLERS REMARKS:

If well telescopes please sketch and show depths.

GROUND LEVEL

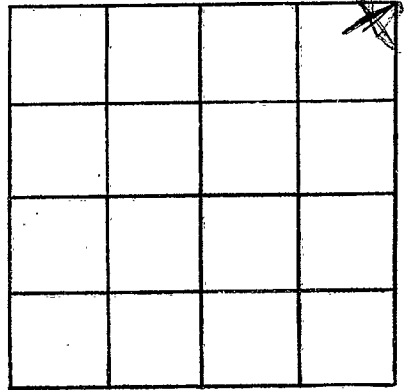

SECTION 9

Please indicate well location X.

ADDITIONAL INFORMATION

If more than one screen,
show locations of each on sketch.