

WAYNE  
G 117  
8-7-73

MISSISSIPPI  
BOARD OF WATER COMMISSIONERS  
416 North State Street  
Jackson, Mississippi 39201

SEP 12 1973

CODED

WATER WELL DRILLERS LOG

MISS. BD. OF  
WATER COMM.

Aug 7 1973 Robert Drilling & Log 27 Jefferson  
date well completed firm name county well located

LANDOWNER: Joe Dean

description of formations encountered

from to

Box 1 Shubuta  
(mailing address)

<u>red clay</u>	<u>0</u>	<u>15</u>
<u>course sand</u>	<u>15</u>	<u>41</u>
<u>Chalk</u>	<u>41</u>	<u>53</u>
<u>shaly rock</u>		<u>53</u>
<u>blue chalk</u>	<u>53</u>	<u>71</u>
<u>sand &amp; chalk</u>	<u>71</u>	<u>83</u>
<u>blue chalk</u>	<u>83</u>	<u>89</u>
<u>sand &amp; gravel</u>	<u>89</u>	<u>94</u>
<u>blue chalk</u>	<u>94</u>	<u>139</u>
<u>Wicksburg</u>	<u>139</u>	<u>165</u>

WELL LOCATION:

sec. 10 T. 9 N. R. 8 E. W  
8 miles NW of Waynesboro  
(distance) (direction) (nearest town)

WELL PURPOSE: home  
(home, irrigation, municipal, industrial)

WELL COMPLETION DATA:


- (1) diameter (inches) 2"
- (2) total depth (feet) 165' 105' 1 1/2" drop pipe
- (3) static water level (feet) 88' below above  
top of ground.
- (4) casing steel 139'  
(material) (depth)  
2" if telescope see back.  
(size)
- (5) screen none used  
(length) (depth to top)  
(size) (material)
- (6) pump 1 5  
(HP) (yield gpm)  
elec.  
(type power)
- (7) electric log no  
(yes or no)  
(organization running log)
- (8) how well bottom plugged open

CODED

DRILLERS REMARKS:

If well telescopes please sketch and show depths.

GROUND LEVEL

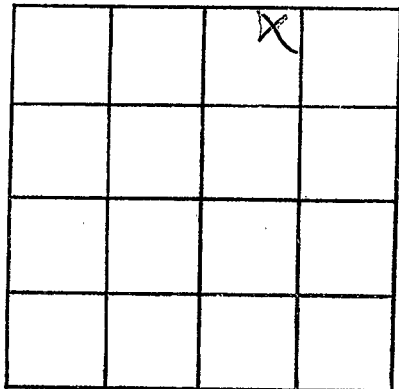

SECTION 10

Please indicate well location X.

ADDITIONAL INFORMATION

If more than one screen,  
show locations of each on sketch.