

WAYNE
§ 119
10-6-73

MISSISSIPPI
 BOARD OF WATER COMMISSIONERS
 416 North State Street
 Jackson, Mississippi 39201

WATER WELL DRILLERS LOG

Oct 6, 1973
 date well completed

McILWAIN WATER WELL SERVICE WAYNE

RT. 2, m BOX 37

county well located

WAYNESBORO, MISS. 39367

LANDOWNER:
Ollie Gatlin JR.
Rt 1, SHUBUTTA, MISS.
 (mailing address)

description of formations encountered	from	to
RED Clay	0	6
RED SAND, SAND ROCKS, & GRAVEL	6	31
WHITE SAND	31	34
WHITE CLAY	34	36
MED. SAND WITH THIN STREAKS CLAY	36	55
COARSE SAND	55	70

WELL LOCATION:
 sec 2 T 9 N R 8 W
9 miles NW of W'BORO
 (distance) (direction) (nearest town)

WELL PURPOSE:
 (home, irrigation, municipal, industrial)

WELL COMPLETION DATA:
 (1) diameter (inches) 2"
 (2) total depth (feet) 70'
 (3) static water level (feet) 57' below above top of ground.
 (4) casing PVC 60'
 (material) (depth)
2" if telescope see back.
 (size)
 (5) screen 10' 60'
 (length) (depth to top)
2" PVC .008
 (size) (material)
 (6) pump 3/4 7
 (HP) (yield gpm)
220 AC
 (type power)
 (7) electric log No
 (yes or no)
 (organization running log)

CODED


1073

(8) how well bottom plugged _____
 DRILLERS REMARKS:

MISS. DP
 WATER

If well telescopes please sketch and show depths.

GROUND LEVEL

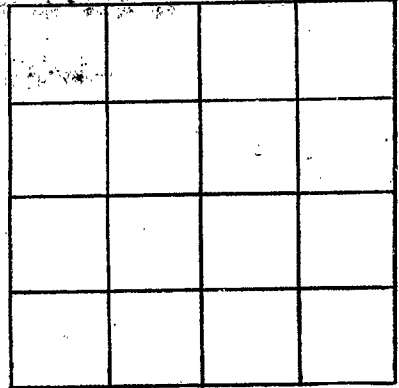

SECTION _____

Please indicate well location X.

ADDITIONAL INFORMATION

If more than one screen, show locations of each on sketch.