


If well is...
sketch and show depth.

GROUND LEVEL

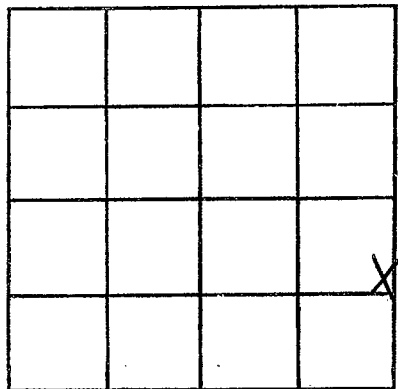

SECTION /

Please indicate well location X.

ADDITIONAL INFORMATION

Lined area for additional information.

If more than one screen,
show locations of each on sketch.