

WAYNE
G 121
3-23-74

BOARD OF WATER COMMISSIONERS
416 North State Street
Jackson, Mississippi 39201

CODED

WATER WELL DRILLERS LOG

March 23 1974 Paul D. Millington Madison
date well completed firm name county well located

LANDOWNER: Jim Haller

description of formations encountered from to

At 1 Shubuta Miss
(mailing address)

red clay 0 6
gray sandstone 6 5.5
gray sandstone

WELL LOCATION:
sec. 12 T. 9 N. R. 8 E
(distance) miles (direction) (nearest town)
9 miles NW Yarnedown
5 1/4 7 LEAPERS S

WELL PURPOSE: home
(home, irrigation, municipal, industrial)

renewal on end of line
well back and make
new


WELL COMPLETION DATA:

- (1) diameter (inches) 2
- (2) total depth (feet) 55
- (3) static water level (feet) 42 (below/above top of ground)
- (4) casing PVC, 52 1/2
(material), (depth)
2' (size) if telescope see back.
- (5) screen 5', 52 1/2
(length), (depth to top)
1 1/2, 7 slat, SS.
(size), (material)
- (6) pump 1, 10
(HP), (yield gpm)
elec
(type power)
- (7) electric log no
(yes or no)

50' 1" P.V.C drop pipe

(8) how well bottom plugged
ch. wash valve


DRILLERS REMARKS:

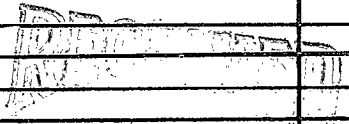

APR 25 1974

If well telescopes please sketch and show depths.

GROUND LEVEL

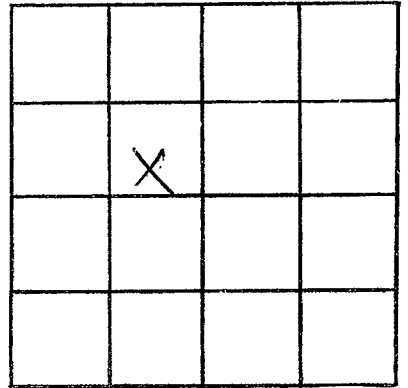

SECTION 12

Please indicate well location X.

ADDITIONAL INFORMATION

If more than one screen,
show locations of each on sketch.