

WAYNE  
G 122  
5-4-74

MISSISSIPPI  
BOARD OF WATER COMMISSIONERS  
416 North State Street  
Jackson, Mississippi 39201

CODED

WATER WELL DRILLERS LOG

May 4 1974 date well completed  
Porter Drilling & Log firm name  
Wayne county well located

LANDOWNER: Marine Hinson

description of formations encountered

from

to

211 Shubuta Miss.  
(mailing address)

0	35
35	40
40	79
79	95
95	125
125	147

WELL LOCATION:

sec. 17 T. 9 N. R. 2 E  
10 miles NW of Waynesboro  
(distance) (direction) (nearest town)

WELL PURPOSE: Home  
(home, irrigation, municipal, industrial)

WELL COMPLETION DATA:

- (1) diameter (inches) 2'
- (2) total depth (feet) 147
- (3) static water level (feet) 130 <sup>below</sup> top of ground.
- (4) casing P.V.C. 142'  
(material) (depth)  
2' if telescope see back.  
(size)
- (5) screen 5' 142  
(length) (depth to top)  
1 1/2" cast SS  
(size) (material)
- (6) pump 1/2 4 1/2  
(HP) (yield gpm)  
elec  
(type power)
- (7) electric log no  
(yes or no)

5' 1 1/2" cast SS screen  
on end of casing with  
back wash valve on end  
and shell trap above  
136' 1" P.V.C. dog  
pipe

(organization running log)

(8) how well bottom plugged  
for sand water


DRILLERS REMARKS:

RECEIVED  
JUN 24 1974

MISS. BD. OF WATER COMM.

If well telescopes please sketch and show depths.

GROUND LEVEL

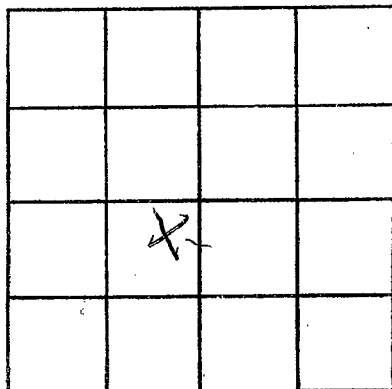

SECTION 17

Please indicate well location X.

ADDITIONAL INFORMATION

If more than one screen,  
show locations of each on sketch.