

WAYNE

G 123

S.2-74

MISSISSIPPI
 BOARD OF WATER COMMISSIONERS
 416 North State Street
 Jackson, Mississippi 39201

CODED

WATER WELL DRILLERS LOG

May 2 1974 Rich Drilling Wayne
 date well completed firm name county well located

LANDOWNER: Bill Thomas
241 Shubuta Mis
 (mailing address)

WELL LOCATION:
 sec 23 T 9 N R 8 E
7 miles NW of Waynesboro
 (distance) (direction) (nearest town)

WELL PURPOSE: home
 (home, irrigation, municipal, industrial)

- WELL COMPLETION DATA:
- (1) diameter (inches) 2
 - (2) total depth (feet) 151
 - (3) static water level (feet) 50 (below/above top of ground)
 - (4) casing steel 100
 (material) (depth)
2" if telescope see back.
 (size)
 - (5) screen none, none
 (length) (depth to top)
 (size) (material)
 - (6) pump 1 8 1/2
 (HP) (yield gpm)
elec
 (type power)
 - (7) electric log no
 (yes or no)
 (organization running log)
 - (8) how well bottom plugged not plugged


description of formations encountered	from	to
<u>red sandstone</u>	<u>0</u>	<u>20</u>
<u>blue shale</u>	<u>20</u>	<u>33</u>
<u>grey sandstone</u>	<u>33</u>	<u>97</u>
<u>blue shale</u>	<u>97</u>	<u>120</u>
<u>limestone</u>	<u>120</u>	<u>151</u>
<u>6.5' 1 1/2" charge pipe</u>		
<u>CODED</u>	<u>V</u>	<u>V</u>

RECEIVED
 JUL 24 1974

DRILLERS REMARKS:

If well telescopes please sketch and show depths.

GROUND LEVEL

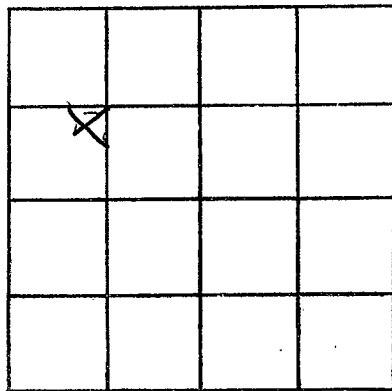

SECTION 23

Please indicate well location X.

ADDITIONAL INFORMATION

If more than one screen, show locations of each on sketch.