

MISSISSIPPI  
 BOARD OF WATER COMMISSIONERS CODED  
 416 North State Street  
 Jackson, Mississippi 39201

**WATER WELL DRILLERS LOG**

**WAYNE**  
**G 125**  
**8-19-74**

Aug 19 1974 date well completed  
 R. C. Porter Drilling firm name  
 Wayne county well located

LANDOWNER: Sammy Carl

description of formations encountered

from to

Mc Donald  
at 1 Shubuta  
 (mailing address)

WELL LOCATION:

sec 4 T 90 N R 2 E  
 S W  
11 miles NW of Wayne  
 (distance) (direction) (nearest town)

WELL PURPOSE: Home  
 (home, irrigation, municipal, industrial)

WELL COMPLETION DATA:

- (1) diameter (inches) 2"
- (2) total depth (feet) 120'
- (3) static water level (feet) 90' below above top of ground
- (4) casing steel, 116'  
 (material) (depth)  
2' if telescope see back.  
 (size)
- (5) screen none used  
 (length) (depth to top)  
 (size) (material)
- (6) pump 1 1/2 10  
 (HP) (yield gpm)  
elec.  
 (type power)
- (7) electric log no  
 (yes or no)

(organization running log)

(8) how well bottom plugged open

DRILLERS REMARKS:

description of formations encountered	from	to
sand	0	25
white chalk	25	32
sand	32	55
thin wash	55	56
sand & chalk	56	60
blue chalk	60	90
hard rock stratum	90	102
blue chalk	103	116
Wicksburg	116	120


105' 1 1/4" drop pipe

**RECEIVED**

SEP 11 1974

If well telescopes please  
sketch and show depths.

GROUND LEVEL

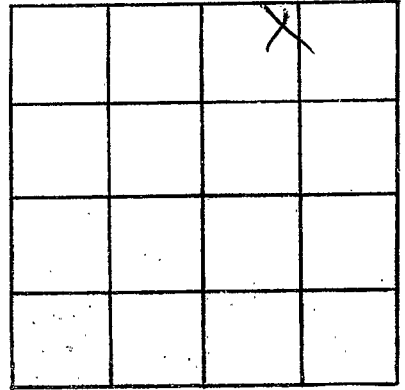

SECTION 4

Please indicate well location X.

ADDITIONAL INFORMATION

If more than one screen,  
show locations of each on sketch.