

WAYNE
 G 126
 8-23-74

MISSISSIPPI
 BOARD OF WATER COMMISSIONERS
 416 North State Street
 Jackson, Mississippi 39201

CODED

WATER WELL DRILLERS LOG


McILWAIN WATER WELL SERVICE WAYNE

AUG 23 1974
 date well completed

RT. 2 BOX 37
 WAYNESBORO, MISS. 39367

county well located

LANDOWNER:	description of formations encountered	from	to
HOWARD STREET Rt 1 SHUBOTTA, MISS. (mailing address)			
WELL LOCATION: sec. 21 T 9 N R 8 E 12 miles NW of W' BORO. (distance) (direction) (nearest town)	mixed clay	8	13
WELL PURPOSE: HOME (home, irrigation, municipal, industrial)	Hard white clay	13	30
WELL COMPLETION DATA: (1) diameter (inches) 2" (2) total depth (feet) 85' (3) static water level (feet) 51' below top of ground. (4) casing PVC 80' (material) (depth) 2" if telescope see back. (size) (5) screen 5' 80' (length) (depth to top) 1/4 STAINLESS Slot (size) (material) (6) pump 1 9 (HP) (yield gpm) 220 AC (type power) (7) electric log No (yes or no) (organization running log) (8) how well bottom plugged	Blue clay	30	50
	Brown clay	50	65
	Sand	65	85
DRILLERS REMARKS:			

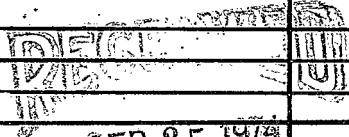


SEP 25 1974

MISS. BD. OF WATER

If well telescopes please sketch and show depths.

GROUND LEVEL

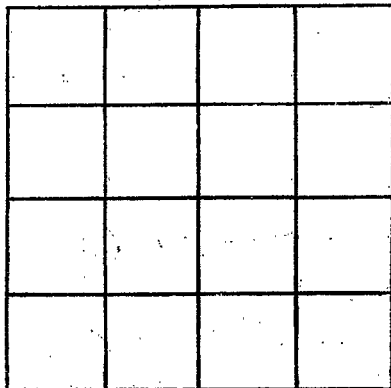

SECTION _____

Please indicate well location X.

ADDITIONAL INFORMATION

If more than one screen, show locations of each on sketch.