

WAYNE
6127
11/14/74

MISSISSIPPI
BOARD OF WATER COMMISSIONERS
416 North State Street
Jackson, Mississippi 39201

WATER WELL DRILLERS LOG

225.16 1974 Paul S. [unclear] Wayne
date well completed firm name county well located

LANDOWNER: Ms Bonnie Arnold

description of formations encountered	from	to
red clay	0	20
sand & gravel	20	55
with some pebbles	55	65
chert	65	92
chert	92	92 1/2
chert	92 1/2	92
chert & sand	92	111
chert	111	130
chert & fine sand	130	145
chert & fine sand	145	156
sand & chert	156	160

R1121 Waynesboro
(mailing address)

WELL LOCATION:
sec 33 T 9 (N) R 2 E
9 miles west of Waynesboro
(distance) (direction) (nearest town)

WELL PURPOSE: Home
(home, irrigation, municipal, industrial)

WELL COMPLETION DATA:

- (1) diameter (inches) 2"
- (2) total depth (feet) 156'
- (3) static water level (feet) 73' below top of ground.
- (4) casing P.V.C. 150'
(material) (depth)
2" if telescope see back.
(size)
- (5) screen 5' 150'
(length) (depth to top)
1/4" brass
(size) (material)
- (6) pump 8
(HP) (yield gpm)
star
(type power)
- (7) electric log no
(yes or no)

5' 1 1/4" hole in screen
screwed on end of casing
with back wash valve
on end and shut type
above
82' 1" PVC casing
wire
U.I.

(organization running log)


(8) how well bottom plugged
back wash valve

DRILLERS REMARKS:

DEC - 3 - 1974
MISSISSIPPI BOARD OF WATER COMMISSIONERS

If well telescopes please
sketch and show depths.

GROUND LEVEL

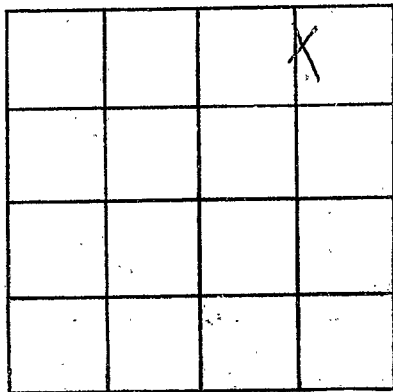

SECTION 33

Please indicate well location X.

ADDITIONAL INFORMATION

If more than one screen,
show locations of each on sketch.