

WAYNE

G12P

1-7-75

MISSISSIPPI BOARD OF WATER COMMISSIONERS

416 North State Street
Jackson, Mississippi 39201

CODED

WATER WELL DRILLERS LOG

Jan 7 1975 Donner Drilling Co Wayne
date well completed firm name county well located

LANDOWNER: Cyde Armstrong

description of formations encountered from to

At Magnolia
(mailing address)

red clay 0 20
small gravel 20 65
sand 65 82
clay & sand 82 83
sand & gravel 83 129
still in sand

WELL LOCATION:
sec 35 T 9N R 8E 13P
6 miles W of Magnolia
(distance) (direction) (nearest town)

WELL PURPOSE: Private
(home, irrigation, municipal, industrial)

CODED

WELL COMPLETION DATA:

- (1) diameter (inches) 2"
- (2) total depth (feet) 129'
- (3) static water level (feet) 63 (below/above top of ground)
- (4) casing PVC 124'
(material) (depth)
2" if telescope see back.
(size)
- (5) screen 5' 124'
(length) (depth to top)
1 1/4" 6 shot SS.
(size) (material)
- (6) pump 1 10
(HP) (yield gpm)
elec
(type power)
- (7) electric log no
(yes or no)
- (organization running log)

5' 1 1/4" 6 shot SS. screened
on end of casing
back a few inches
& about 1/2" above
82' 1" PVC casing pipe


(8) how well bottom plugged
back with valve

DRILLERS REMARKS:

RECEIVED
MAR 15 1975
MISS. BD. OF WATER

If well telescopes please sketch and show depths.

GROUND LEVEL

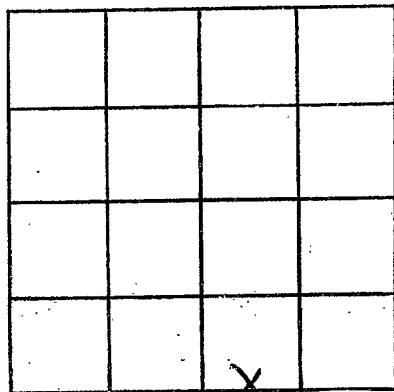

SECTION 35

Please indicate well location X.

ADDITIONAL INFORMATION

If more than one screen,
show locations of each on sketch.