

**WAYNE**  
 5/29  
 4-16-75

MISSISSIPPI  
 BOARD OF WATER COMMISSIONERS  
 416 North State Street  
 Jackson, Mississippi 39201

CODED

WATER WELL DRILLERS LOG

McILWAIN WATER WELL SERVICE

Wayne

April 16, 1975  
 date well completed

RT. 2 BOX 37  
 firm name  
 WAYNESBORO, MISS. 39367


county well located

LANDOWNER:	description of formations encountered	from	to
MR. B. PITTS			
WAYNESBORO, MISS. (mailing address)	Red Sand	12	20
WELL LOCATION:	Sand + Clay	20	40
sec. 27 T 9 N R 8 E	Sand + Red gravel	45	50
12 miles NW of W'BOARD	Clay	50	62
(distance) (direction) (nearest town)	Sand	62	65
WELL PURPOSE: HOME	Clay	65	72
(home, irrigation, municipal, industrial)	Fine Sand	72	80
WELL COMPLETION DATA:	Clay	80	102
(1) diameter (inches) 2"	Sand	102	105
(2) total depth (feet) 145'	Clay	105	125
(3) static water level (feet) 80' below above top of ground.	Sand + Clay	125	133
(4) casing PVC 140' (material) (depth)	Sand	133	145
2" if telescope see back. (size)			
(5) screen 5' 140' (length) (depth to top)			
2" PVC .008 (size) (material)			
(6) pump 3/4 4 (HP) (yield gpm)			
220 AC (type power)			
(7) electric log 70 (yes or no)			
(organization running log)			
(8) how well bottom plugged			
DRILLERS REMARKS:			

MISS. Bd. OF WATER COMMISSIONERS

If well telescopes please sketch and show depths.

GROUND LEVEL

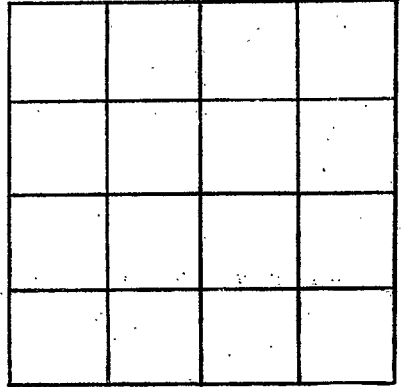

SECTION \_\_\_\_\_

Please indicate well location X.

ADDITIONAL INFORMATION

If more than one screen, show locations of each on sketch.