

WAYNE

6130

5-27-77

Elev # 296

5/27/77

date well completed

MISSISSIPPI

MAR 14 1978

BOARD OF WATER COMMISSIONERS

416 North State Street

Jackson, Mississippi 39201

WATER WELL DRILLERS LOG

CODED

Griner Drilling Service Wayne

firm name


county/well located

LANDOWNER: Exxon Company

USA # 315 AW 002053

West yellow Creek field #996  
(mailing address)

WELL LOCATION:

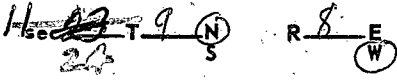

2.5 miles (distance) of (direction) (nearest town)

WELL PURPOSE:

(home, irrigation, municipal, industrial)

WELL COMPLETION DATA:

- (1) diameter (inches) 3"
- (2) total depth (feet) 604' 504'
- (3) static water level (feet) 80 below above top of ground.
- (4) casing Steel, 604' 504' (material) (depth)  
3" (size) If telescope see back.
- (5) screen 4" NA 504' (length) (depth) top  
3" (size) (material)
- (6) pump 60 (HP) (yield gpm)  
AC (type power)
- (7) electric log (yes or no)  
MGS (organization running log)

(8) how well bottom plugged - Open? Enclosed

description of formations encountered

from

to

TOP Soil

0

4

Clay with Rock

4

103

Chalk & lbs gravel

103

291

Sand

297

322

Clay with streaks sand

324

407

Clay

407

501

Sand & Clay streaks

501

569

Sand

569

604

CODED

RECEIVED


FEB 27 1978

DRILLERS REMARKS:

MISS. BD. OF WATER COMM

If well telescopes please sketch and show depths.

GROUND LEVEL

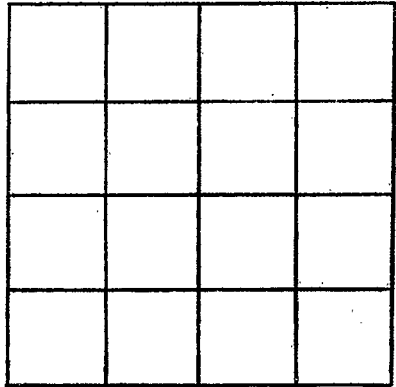

SECTION \_\_\_\_\_

Please indicate well location X.

ADDITIONAL INFORMATION

If more than one screen,  
show locations of each on sketch.