

WAYNE
 6133
 7-31-78

MISSISSIPPI
 BOARD OF WATER COMMISSIONERS
 416 North State Street
 Jackson, Mississippi 39201

CODED

WATER WELL DRILLERS LOG

July 31 1978
 date well completed

TRAC MAIN WATER WELL SERVICE WAYNE
 RT. 2, BOX 37
 county well located

LANDOWNER: WAYNESBORO, MISS. 39362

Bill TAYLOR
 WAYNESBORO, MS.
 (mailing address)

description of formations encountered	from	to
Red CLAY CODED	0	10

WELL LOCATION:
 sec. 21 T. 9 N. R. 8 E. W. 3
 (distance) miles (direction) of Whistler
 (nearest town)

CLAY	10	40
SAND + CLAY	40	50

WELL PURPOSE: home
 (home, irrigation, municipal, industrial)

CLAY	50	55
------	----	----

WELL COMPLETION DATA:

- diameter (inches) 2"
- total depth (feet) 180'
- static water level (feet) 95' below top of ground.
- casing PVC 150'
 (material) (depth)
 2" if telescope see back.
 (size)
- screen None
 (length) (depth to top)
 2" PVC 002
 (size) (material)
- pump 1/2 4
 (HP) (yield gpm)
 220 AC
 (type power)
- electric log NO
 (yes or no)

(organization running log)

(8) how well bottom plugged


DRILLERS REMARKS:

RECEIVED
 AUG 17 1978

MISS. BD. OF WATER COMM.

If well telescopes please sketch and show depths.

GROUND LEVEL

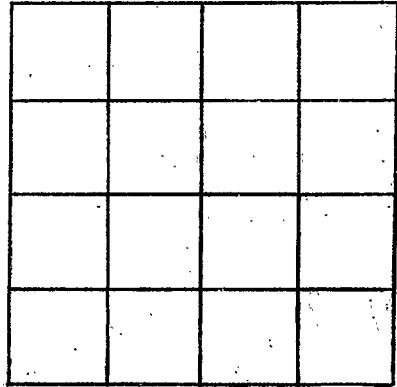

SECTION _____

Please indicate well location X.

ADDITIONAL INFORMATION

A series of horizontal lines for writing additional information, with some faint handwritten marks.

If more than one screen, show locations of each on sketch.