

MISSISSIPPI DEPARTMENT OF NATURAL RESOURCES

Bureau of Land and Water Resources

Southport Mall

P.O. Box 10631

CODED

Jackson, Mississippi 39209

WATER WELL DRILLERS LOG

G-137  
Wayne Co.  
80-30-84

8-30-85

Ray West Delg

WAYNE

date well completed

firm name

county well located


LANDOWNER:	description of formations encountered	from to	
Bill PATERSON		Red sand	0
LAUREL MS (mailing address)	CLAY	12	70
	SAND	70	104
WELL LOCATION: sec. 17 T. 9 <sup>N</sup> S. R. 8 E 3 miles SE of Eucutta (distance) (direction) (nearest town)	CLAY	104	222
	CLAY with Limestone	222	268
	STRKS CLAY	268	290
WELL PURPOSE: (home, irrigation, municipal, industrial)			
WELL COMPLETION DATA:			
(1) diameter (inches) 2"			
(2) total depth (feet) 290			
(3) static water level (feet) 101' below top of ground.			
(4) casing PVC, 224' (material) (depth)			
(size) if telescope see back.			
(5) screen (length) (depth to top)			
(size) (material)			
(6) pump 1 (HP) 6 (yield gpm)			
REA (type power)			
(7) electric log NO (yes or no)			
(organization running log)			
(8) how well bottom plugged WASH VALVE			

RECEIVED  
FEB 20 1985

DRILLERS REMARKS:

If well telescopes please sketch and show depths.

GROUND LEVEL

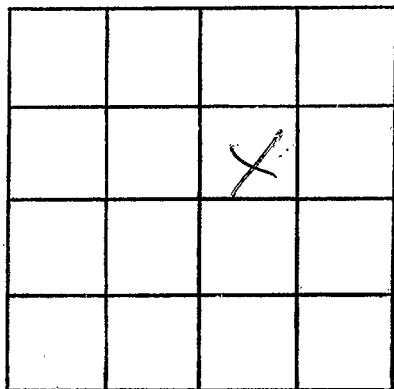

SECTION 17

Please indicate well location X.

ADDITIONAL INFORMATION

If more than one screen,  
show locations of each on sketch.