

MISSISSIPPI DEPARTMENT OF NATURAL RESOURCES

Bureau of Land and Water Resources

Southport Mall

P.O. Box 10631

Jackson, Mississippi 39209

WATER WELL DRILLERS LOG

CODED

WAYNE  
G 138

2-11-86 date well completed

Griner Drilling Service, Inc. firm name

Wayne county well located

LANDOWNER:	description of formations encountered	from	to
Chevron, U.S.A., Inc. P.O. Box 471 Columbia, MS. 39429 (mailing address)	SAND	0	10
WELL LOCATION: 580' N & 1160' E sec 7 T 9 S R 8 SW/4 COR Eucutta Field SW NW No. 1 HP Eucutta Field SW NW proper distance) (direction) (nearest town)	SAND, ROCKS, CLAY	10	240
WELL PURPOSE: oilfield rig (home, irrigation, ranch, industrial) supply	GUMBO CLAY	240	575
WELL COMPLETION DATA:	SAND	575	650
(1) diameter (inches) 3"	LITTLE BRINK-UP		
(2) total depth (feet) 672'	CLAY	650	672
(3) static water level (feet) 60' below top of ground.			
(4) casing steel 650' (material) (depth) 3" if telescope see back. (size)			
(5) screen 63' 587' (length) (depth to top) 3" perforated (size) (material)			
(6) pump 70-75 GPM (HP) (yield gpm) AC (type power)			
(7) electric log (yes or no)			
(8) how well bottom plugged ORANGE peel			
DRILLERS REMARKS:			


CODED

RECEIVED  
FEB 21 1986

Department of Natural Resources  
Bureau of Land & Water Resources

If well telescopes please sketch and show depths.

GROUND LEVEL

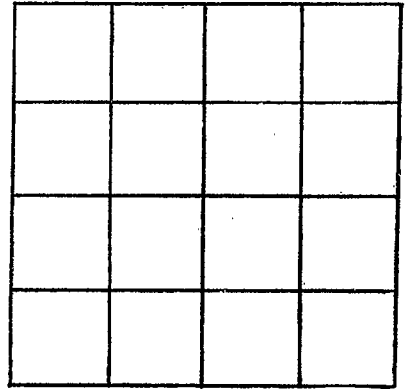

SECTION \_\_\_\_\_

Please indicate well location X.

ADDITIONAL INFORMATION

If more than one screen,  
show locations of each on sketch.