

Wayne
G 2000
11-22-75

MISSISSIPPI
 BOARD OF WATER COMMISSIONERS
 416 North State Street
 Jackson, Mississippi 39201

WATER WELL DRILLERS LOG

Nov. 22, 1975 ¹³⁹ McILWAIN WATER WELL SERVICE Wayne

date well completed

RT. ~~2m~~ ^{2m} BOX 37

county well located

WAYNESBORO, MISS. 39367

LANDOWNER:	description of formations encountered	from	to
MR. RICHARD GATLIN	Red Sandy Clay	0	8
Rt 1 SHUBOTTA, Miss. (mailing address)	Coarse Sand, some pea gravel	8	45
WELL LOCATION: sec. <u>3</u> T <u>9</u> N R. <u>8</u> W <u>6</u> miles <u>SE</u> of <u>Eucotta</u> (distance) (direction) (nearest town)	Clay + Sand streaks	45	62
WELL PURPOSE: <u>HOME</u> (home, irrigation, municipal, industrial)	Sand	62	77
WELL COMPLETION DATA:			
(1) diameter (inches) <u>2"</u>			
(2) total depth (feet) <u>77'</u>			
(3) static water level (feet) <u>57'</u> below top of ground.			
(4) casing <u>PVC</u> <u>72'</u> (material) (depth)			
<u>2"</u> (size) if telescope see back.			
(5) screen <u>5'</u> <u>72'</u> (length) (depth to top)			
<u>2"</u> <u>PVC</u> (size) (material)			
(6) pump <u>3/4</u> <u>7</u> (HP) (yield gpm)			
<u>220 AC</u> (type power)			
(7) electric log <u>no</u> (yes or no)			
(organization running log)			
(8) how well bottom plugged			
DRILLERS REMARKS:			


RECORDED
 INDEXED

DEC 22 1975

MISS. Bd. OF WATER COMMISSIONERS

If well telescopes please
sketch and show depths.

GROUND LEVEL

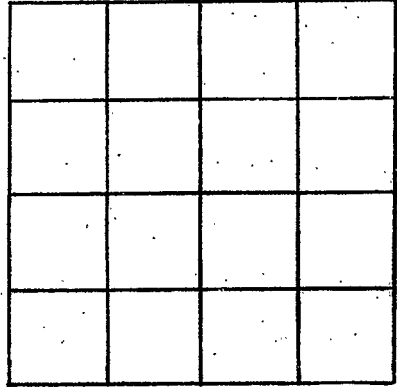

SECTION _____

Please indicate well location X.

ADDITIONAL INFORMATION

If more than one screen,
show locations of each on sketch.