

Wayne
G 2001

MISSISSIPPI
BOARD OF WATER COMMISSIONERS
416 North State Street
Jackson, Mississippi 39201

WATER WELL DRILLERS LOG

Read
data

19 13P date well completed

J.R. Green Water Well Drilling firm name

Wayne county well located

LANDOWNER

John L. Malone
Rt 1 B 511 Waynesboro ms.
(mailing address)

description of formations encountered

from to

<u>sand</u>	<u>0</u>	<u>10</u>
"	<u>10</u>	<u>20</u>
"	<u>20</u>	<u>24</u>
<u>white chalk</u>	<u>24</u>	<u>30</u>
<u>sand</u>	<u>30</u>	<u>40</u>
"	<u>40</u>	<u>50</u>
"	<u>50</u>	<u>60</u>
"	<u>60</u>	<u>68</u>
<u>white chalk</u>	<u>68</u>	<u>70</u>
" "	<u>70</u>	<u>80</u>
<u>sand</u>	<u>80</u>	<u>90</u>
"	<u>90</u>	<u>100</u>
<u>white chalk</u>	<u>100</u>	<u>110</u>
" "	<u>110</u>	<u>120</u>

WELL LOCATION:

sec. 20 T 9 N R 8 E
S W
(distance) miles (direction) of (nearest town)

WELL PURPOSE:

(home, irrigation, municipal, industrial)

WELL COMPLETION DATA:

- (1) diameter (inches) 4
- (2) total depth (feet) 120'
- (3) static water level (feet) 21 below above top of ground.
- (4) casing PVC 88
(material) (depth)
(size) if telescope see back.
- (5) screen 10' 88'
(length) (depth to top)
2" x .008 PVC
(size) (material)
- (6) pump 1 5
(HP) (yield gpm)
110 KAC
(type power)
- (7) electric log NO
(yes or no)

(organization running log)

(8) how well bottom plugged

DRILLERS REMARKS:


RECEIVED

JAN 2 1976

MISS. Bd. OF WATER COMMISSIONERS

If well telescopes please sketch and show depths.

GROUND LEVEL

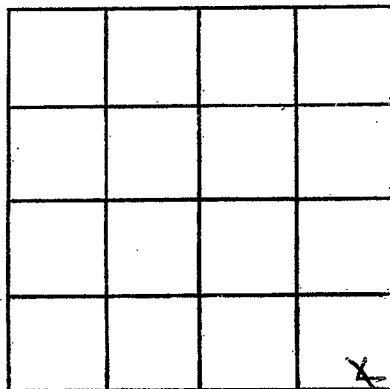

SE SE

SECTION 20

Please indicate well location X.

ADDITIONAL INFORMATION

If more than one screen, show locations of each on sketch.