

Wayne
 G 2002
 12-20-75

MISSISSIPPI
 BOARD OF WATER COMMISSIONERS
 416 North State Street
 Jackson, Mississippi 39201

WATER WELL DRILLERS LOG

DEC 20, 1975

McILWAIN WATER WELL SERVICE

Wayne

date well completed

Rt. # BOX 37

county well located

WAYNESBORO, MISS. 39367

LANDOWNER:

MR. SELBY EDISON
 Rt 1 SHUBOTTA, MISS.
 (mailing address)

description of formations encountered

from to

Red Clay 0 8

Sand & Clay streaks 8 33

fine Sand 33 37

Clay 37 62

Fine Sand 62 65

Med Sand 65 73

WELL LOCATION:

sec. 30 T 9 N R 8 E
 12 miles W of W' BORO
 (distance) (direction) (nearest town)

WELL PURPOSE: Home
 (home, irrigation, municipal, industrial)

WELL COMPLETION DATA:

- (1) diameter (inches) 2"
- (2) total depth (feet) 73'
- (3) static water level (feet) 42' below
top of ground.
- (4) casing PVC 68'
(material) (depth)
2" (size) if telescope see back.
- (5) screen 5' 68'
(length) (depth to top)
2" PVC 008
(size) (material)
- (6) pump 1/2 4
(HP) (yield gpm)
110 AC
(type power)
- (7) electric log no
(yes or no)

(organization running log)

(8) how well bottom plugged

DRILLERS REMARKS:


RECORDED
 INDEXED

JAN 23 1976

MISS. Bd. of WATER COMMISSIONERS

If well telescopes please:
sketch and show depths.

GROUND LEVEL

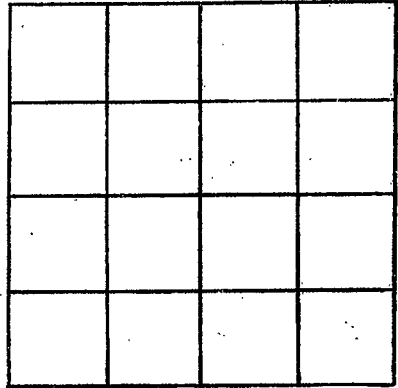

SECTION _____

Please indicate well location X.

ADDITIONAL INFORMATION

If more than one screen,
show locations of each on sketch.