

Warner
G 2004
2/76

MISSISSIPPI
 BOARD OF WATER COMMISSIONERS
 416 North State Street
 Jackson, Mississippi 39201

WATER WELL DRILLERS LOG

2-76
 date well completed

J.R. Greer
 firm name


Wayne
 county well located

LANDOWNER:	description of formations encountered	from	to
JAMES V. PARVELL			
Route One Shubuta, MS (mailing address)	SAND	12	10
	white	10	20
	" "	20	30
	" "	30	40
	" "	40	50
	" "	50	60
	" "	60	70
5 miles N of Whistler (distance) (direction) (nearest town)	white CHALK	70	80
WELL LOCATION: sec <u>18</u> T <u>9</u> N R <u>8</u> E			
WELL PURPOSE: (home, irrigation, municipal, industrial)			
WELL COMPLETION DATA:			
(1) diameter (inches) <u>4</u>			
(2) total depth (feet) <u>80</u>			
(3) static water level (feet) <u>118</u> below top of ground.			
(4) casing <u>PVC</u> <u>60</u> (material) (depth)			
(size) If telescope see back.			
(5) screen <u>10'</u> <u>60</u> (length) (depth to top)			
<u>8" 2008</u> <u>PVC</u> (size) (material)			
(6) pump <u>1</u> <u>4</u> (HP) (yield gpm)			
<u>220V AC</u> (type power)			
(7) electric log <u>NO</u> (yes or no)			
(organization running log)			
(8) how well bottom plugged			
DRILLERS REMARKS:			

MAR 17 1976
 MISS. BOARD OF WATER COMMISSIONERS

If well telescopes please sketch and show depths.

GROUND LEVEL

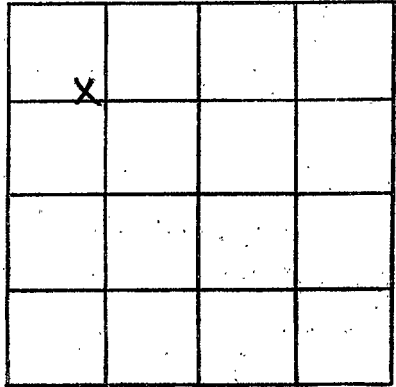

NW NW

SECTION 18

Please indicate well location X.

ADDITIONAL INFORMATION

If more than one screen,
show locations of each on sketch.