

Wayne  
 G 2005  
 3/76

MISSISSIPPI  
 BOARD OF WATER COMMISSIONERS  
 416 North State Street  
 Jackson, Mississippi 39201

WATER WELL DRILLERS LOG

3-76  
 date well completed

13P J. R. Greenwell Drilling  
 firm name

Wayne  
 county well located

LANDOWNER:  
 Lester Carney  
 Rt 1 Shubuta, Ms.  
 (mailing address)

description of formations encountered	from	to
	Red SAND	0
" "	10	20
" "	20	30
" "	30	40
" "	40	50
White	50	60
" "	60	70
" "	70	72
CHALK	72	

WELL LOCATION:  
 sec. 18 T-9 N R-2 E  
 5 miles N of Whistler  
 (distance) (direction) (nearest town)

WELL PURPOSE:  
 (home, irrigation, municipal, industrial)

WELL COMPLETION DATA:

(1) diameter (inches) 11"

(2) total depth (feet) 72

(3) static water level (feet) 51 below above top of ground.

(4) casing PVC 67  
 (material) (depth)  
 (size) If telescope see back.

(5) screen 5 67  
 (length) (depth to top)  
 2' x .008 PVC  
 (size) (material)


(6) pump 3/4 11 gal  
 (HP) (yield 'gpm)  
 110  
 (type power)

(7) electric log No  
 (yes or no)

(organization running log)

(8) how well bottom plugged


DRILLERS REMARKS:

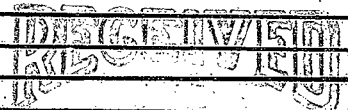

APR 20 1976

If well telescopes please sketch and show depths.

GROUND LEVEL

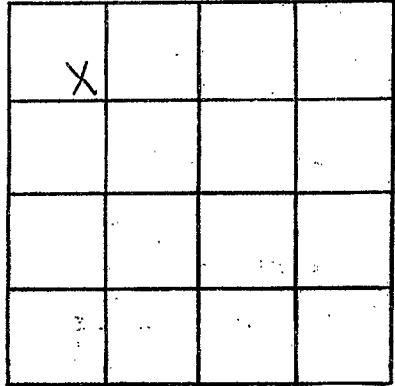

*NW NW*

SECTION 18

Please indicate well location X.

ADDITIONAL INFORMATION

If more than one screen, show locations of each on sketch.