

Wayne
G 2000

need date

MISSISSIPPI
BOARD OF WATER COMMISSIONERS
416 North State Street
Jackson, Mississippi 39201

WATER WELL DRILLERS LOG

19 date well completed

firm name

county well located

J. R. Greer Water Well Drng. Wayne

LANDOWNER:

Willie Puck
Route 1 Shubuta, Ms
(mailing address)

description of formations encountered

from to

Red sand	0	10
" "	10	15
Five sand	15	20
" "	20	30
Coarse sand	30	36
Yellow chalk	36	40
" "	40	44
sand	44	50
" "	50	52
" "	52	57
Rock	57	58
Blue chalk	58	60
" "	60	70
" "	70	72
sand	72	78
Blue chalk	78	

WELL LOCATION:

sec 4 T 9 N R 8 E
S W
10 miles SW of Shubuta
(distance) (direction) (nearest town)

WELL PURPOSE:

(home, irrigation, municipal, industrial)

WELL COMPLETION DATA:

- (1) diameter (inches) 4
- (2) total depth (feet) 78
- (3) static water level (feet) 47 below top of ground.
- (4) casing PVC, 63' (material), (depth)
If telescope see back.
(size)
- (5) screen 5', 63' (length), (depth to top)
2 1/2" .008, PVC (size), (material)
- (6) pump 1, 5 (HP), (yield gpm)
220VAC (type power)
- (7) electric log NO (yes or no)
(organization running log)
- (8) how well bottom plugged


DRILLERS REMARKS:

JUN - 1 1970

MISSISSIPPI BOARD OF WATER COMMISSIONERS

If well telescopes please sketch and show depths.

GROUND LEVEL

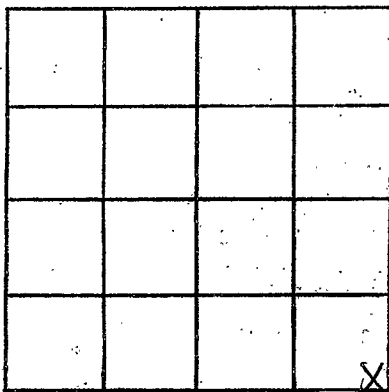

SESE

SECTION 4

Please indicate well location X.

ADDITIONAL INFORMATION

If more than one screen, show locations of each on sketch.