

WAYNE
G 2007
8/20/76

MISSISSIPPI
 BOARD OF WATER COMMISSIONERS
 416 North State Street
 Jackson, Mississippi 39201

13P

WATER WELL DRILLERS LOG
 McILWAIN WATER WELL SERVICE

Aug 20, 1976
 date well completed

RT. 2, BOX 37
 firm name
 WAYNESBORO, MISS. 39367

Wayne
 county well located

LANDOWNER:
Billy Rae ~~and~~ Cooley
Waynesboro Miss.
 (mailing address)

description of formations encountered	from	to
<u>Red Clay</u>	<u>0</u>	<u>15</u>
<u>Red Sand</u>	<u>15</u>	<u>35</u>
<u>Sand</u>	<u>35</u>	<u>55</u>

WELL LOCATION:
 sec. 12 T. 9 N. R. 8 E
10 miles NW of Waynesboro
 (distance) (direction) (nearest town)

WELL PURPOSE: Home
 (home, irrigation, municipal, industrial)

- WELL COMPLETION DATA:
- (1) diameter (inches) 2"
 - (2) total depth (feet) 55'
 - (3) static water level (feet) 43 below top of ground.
 - (4) casing PVC 51'
 (material) (depth)
2" if telescope see back.
 (size)
 - (5) screen 4' 51'
 (length) (depth to top)
 - 2" PVC .008
 (size) (material)
 - (6) pump 1 10.10
 (HP) (yield gpm)
220 AC
 (type power)
 - (7) electric log no.
 (yes or no)
- (organization running log)
- (8) how well bottom plugged _____


DRILLERS REMARKS:

RECEIVED
 OCT - 5 1976

MISS. BD. OF WATER COMMISSIONERS

If well telescopes please sketch and show depths.

GROUND LEVEL

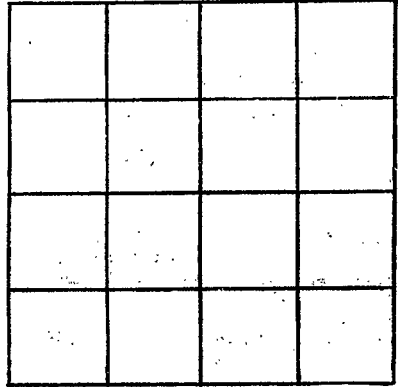

SECTION _____

Please indicate well location X.

ADDITIONAL INFORMATION

If more than one screen, show locations of each on sketch.