

Wayne  
 G 2008  
 8/30/76

MISSISSIPPI  
 BOARD OF WATER COMMISSIONERS  
 416 North State Street  
 Jackson, Mississippi 39201

WATER WELL DRILLERS LOG  
 McILWAIN WATER WELL SERVICE WAYNE  
 RT. firm name 31  
 WAYNESBORO MISS 39367 county well located

Aug 30, 1976 19  
 date well completed

LANDOWNER:  
 MR JULES WILLIAMS  
 WAYNESBORO, MISS.  
 (mailing address)

description of formations encountered	from	to
Red Sandy Clay	0	8
Sand	8	15
Clay	15	19
Sand & Clay	19	37
Sand	37	47

WELL LOCATION:  
 sec. 21 T 9 N R 8 E  
 10 miles NE of W'BORO  
 (distance) (direction) (nearest town)

WELL PURPOSE: HOME  
 (home, irrigation, municipal, industrial)


- WELL COMPLETION DATA:
- diameter (inches) 2"
  - total depth (feet) 47'
  - static water level (feet) 22' below top of ground
  - casing PVC 43' (material) (depth)  
 2" (size) if telescope see back.
  - screen 4' 43' (length) (depth to top)  
 2" PVC .008 (size) (material)
  - pump 1 8 (HP) (yield gpm)  
 220 AC (type power)
  - electric log No. (yes or no)
- (organization running log)
- (8) how well bottom plugged

DRILLERS REMARKS:

RECEIVED  
 OCT - 5 1976

If well telescopes please sketch and show depths.

GROUND LEVEL

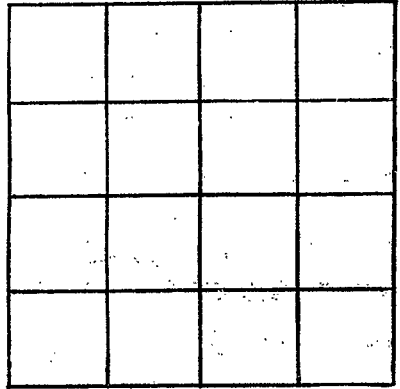

SECTION \_\_\_\_\_

Please indicate well location X.

ADDITIONAL INFORMATION

If more than one screen, show locations of each on sketch.