

Wayne  
G 2010  
11-10-76

MISSISSIPPI  
BOARD OF WATER COMMISSIONERS  
416 North State Street  
13P Jackson, Mississippi 39201

WATER WELL DRILLERS LOG

Nov. 10 1976 date well completed  
13P Drilling & Log firm name  
Wayne county well located

LANDOWNER: Mrs. Bettye  
Zimlan  
211 Phubuta  
(mailing address)

description of formations encountered	from	to
sand some clay	0	90
fine sand some gravel	90	106
clay	106	115

WELL LOCATION:  
sec 2 T 9 N R 8 E  
7 miles NW Waynesboro  
(distance) (direction) (nearest town)

5' 1/4" 7' 1/2" S.S.  
screen covered on end

WELL PURPOSE: home  
(home, irrigation, municipal, industrial)

of cars. with shell trap

WELL COMPLETION DATA:  
(1) diameter (inches) 2'  
(2) total depth (feet) 102'  
(3) static water level (feet) 97' below top of ground.  
(4) casing PVC 102' (material) (depth)  
2' (size) if telescope see back.  
(5) screen 5' 102' (length) (depth to top)  
1 1/4" 7' 1/2" S.S. (size) (material)  
(6) pump 2 (HP) 9 (yield gpm)  
elec (type power)  
(7) electric log (yes or no)  
(organization running log)  
(8) how well bottom plugged


above & back wash  
water on end  
101' 1" P.V.C pipe  
J J

DRILLERS REMARKS:

DEC 6 1976  
MISS. BD. OF WATER COMMISSIONERS

If well telescopes please sketch and show depths.

GROUND LEVEL

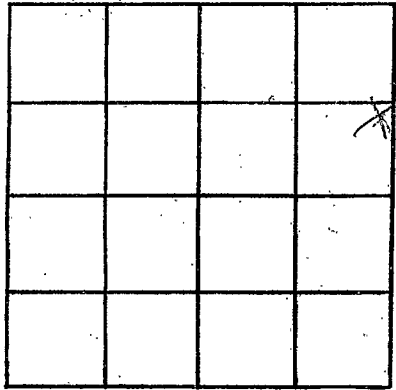

SECTION 2

Please indicate well location X.

ADDITIONAL INFORMATION

If more than one screen,  
show locations of each on sketch.