

WAYNE
G 2011
12/8/76

MISSISSIPPI
 BOARD OF WATER COMMISSIONERS
 416 North State Street
 Jackson, Mississippi 39201

WATER WELL DRILLERS LOG

Dec. 8 1976 McILWAIN WATER WELL SERVICE Wayne
 date well completed RT firm, name BOX 37 county well located
 WAYNESBORO, MISS. 39267


LANDOWNER:	description of formations encountered	from	to
Waynesboro, Miss. (mailing address)			
<u>Mr. James Snellgrove</u>	<u>Sandy Clay</u>	<u>0</u>	<u>5</u>
<u>Waynesboro, Miss.</u> (mailing address)	<u>Red Sand</u>	<u>5</u>	<u>25</u>
<u>12</u> miles <u>NW</u> of <u>W'boro</u> (distance) (direction) (nearest town)	<u>Sand</u>	<u>25</u>	<u>42</u>
WELL LOCATION: sec. <u>15</u> T <u>9</u> N R <u>8</u> <u>12</u> miles <u>NW</u> of <u>W'boro</u> (distance) (direction) (nearest town)			
WELL PURPOSE: <u>Home</u> (home, irrigation, municipal, industrial)			
WELL COMPLETION DATA: (1) diameter (inches) <u>2"</u> (2) total depth (feet) <u>42'</u> (3) static water level (feet) <u>28'</u> below top of ground. (4) casing <u>PVC</u> , <u>32'</u> (material) (depth) (size) If telescope see back. (5) screen <u>10"</u> , <u>32'</u> (length) (depth to top) <u>2"</u> , <u>PVC</u> (size) (material) (6) pump <u>1</u> , <u>5</u> (HP) (yield gpm) <u>110 AC</u> (type power) (7) electric log <u>No</u> (yes or no) (organization running log) (8) how well bottom plugged			
DRILLERS REMARKS:			

RECEIVED
 JAN 24 1977

MISS. BD. OF WATER COMMISSIONERS

If well telescopes please sketch and show depths.

GROUND LEVEL

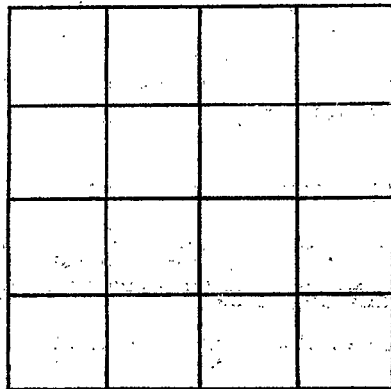

SECTION _____

Please indicate well location X.

ADDITIONAL INFORMATION

If more than one screen, show locations of each on sketch.