

WAYNE
GOLD
1-20-77

MISSISSIPPI
 BOARD OF WATER COMMISSIONERS
 416 North State Street
 Jackson, Mississippi 39201

WATER WELL DRILLERS LOG

1-20 1977 CARRS well SERV WAYNE
 date well completed firm name county well located

LANDOWNER: Ray Dykes
Waynesboro MS
 (mailing address)

WELL LOCATION:
 sec 35 T 9N R 8E
6 miles W of Waynesboro
 (distance) (direction) (nearest town)

WELL PURPOSE: Home
 (home, irrigation, municipal, industrial)

- WELL COMPLETION DATA:
- (1) diameter (inches) 2"
 - (2) total depth (feet) 160
 - (3) static water level (feet) 115 below above top of ground.
 - (4) casing PVC 150
 (material) (depth)
 (size) If telescope see back.
 - (5) screen 10 150
 (length) (depth to top)
2" PVC 8 slot John
 (size) (material) ston
 - (6) pump 2 5
 (HP) (yield gpm)
Elect
 (type power)
 - (7) electric log NO
 (yes or no)
 (organization running log)
 - (8) how well bottom plugged 2"
PVC CAP

description of formations encountered	from	to
Tap Soil	0	1
Med Redish SD	1	18
COARSE Red SD	18	30
White CLAY	30	32
COARSE white SD	32	55
Pinkwhite Clay	55	57
PEA GRAVEL	57	67
Yellow Clay	67	70
Pink CLAY	70	85
PEA GRAVEL	85	125
COARSE white SD w/ GRAVEL	125	130
COARSE white SD	130	160


RECEIVED
 FEB 16 1977

DRILLERS REMARKS: still in sand when quit

MISS. BD. OF WATER COMMISSIONERS

If well telescopes please sketch and show depths.

GROUND LEVEL

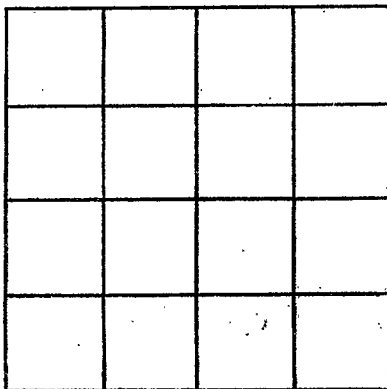

SECTION _____

Please indicate well location X.

ADDITIONAL INFORMATION

If more than one screen, show locations of each on sketch.