

WAYNE
G 2013
2-21-77

MISSISSIPPI
 BOARD OF WATER COMMISSIONERS
 416 North State Street
 Jackson, Mississippi 39201

WATER WELL DRILLERS LOG

Feb 21 1977 Porter Drilling Wayne
 date well completed firm name county well located

LANDOWNER: O. Davis Roberts
Box 1 Shubuta Miss
 (mailing address)

description of formations encountered	depth	
	from	to
red clay to sand	0	20
sand & pea gravel	20	4.5
clay	4.5	49
test fine sand	119	65
red dense sand	65	73

WELL LOCATION:
 sect 4 T 9 (N) R 8 E
10 miles NW of Waynes
 (distance) (direction) (nearest town)

Stiperton soft clay to sand

WELL PURPOSE: home
 (home, irrigation, municipal, industrial)

WELL COMPLETION DATA:
 (1) diameter (inches) 2"
 (2) total depth (feet) 73
 (3) static water level (feet) 49 (below/above top of ground)
 (4) casing P.V.C. 68'
 (material) (depth)
 2" If telescope see back.
 (size)
 (5) screen 5' 68'
 (length) (depth to top)
 2" Slot P.V.C.
 (size) (material)
 (6) pump 1 10
 (HP) (yield gpm)
 elec
 (type power)
 (7) electric log no
 (yes or no)
 (organization running log)
 (8) how well bottom plugged
back wash valve

62' 1" P.V.C. drop pipe
1 1/4" back wash valve
on end & shell trap above

RECEIVED


APR 5 1977

MISSISSIPPI DEPARTMENT OF WATER RESOURCES

DRILLERS REMARKS:

If well telescopes please sketch and show depths.

GROUND LEVEL

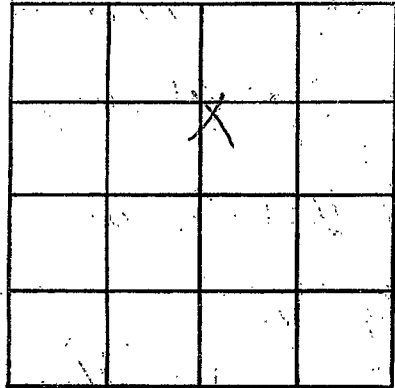

SECTION 4

Please indicate well location X.

ADDITIONAL INFORMATION

If more than one screen, show locations of each on sketch.