

WAYNE  
G 2015  
7-29-77

MISSISSIPPI  
BOARD OF WATER COMMISSIONERS  
416 North State Street  
Jackson, Mississippi 39201

WATER WELL DRILLERS LOG

July 29 1977  
date well completed

13P  
WATERWAY WATER WELL SERVICE Wayne

firm name BOX 37  
MAYNESBORO MISS 39052 county well located

LANDOWNER:	description of formations encountered	from	to
Lee Holland Waynesboro Miss (mailing address)			
WELL LOCATION:	Sand & Gravel	5	10
sec. 23 T. 9 N R. 8 W 7 miles NW of W'boro (distance) (direction) (nearest town)	Clay	10	48
WELL PURPOSE: Home (home, irrigation, municipal, industrial)	Sand & Gravel	48	85
WELL COMPLETION DATA:	Sand	85	115
(1) diameter (inches) 2"			
(2) total depth (feet) 115'			
(3) static water level (feet) 79' below top of ground			
(4) casing PVC 110' (material) (depth)			
2" (size) if telescope see back.			
(5) screen 5' 110' (length) (depth to top)			
2" PVC .008 (size) (material)			
(6) pump 1 5 (HP) (yield gpm)			
110 AC (type power)			
(7) electric log No (yes or no)			
(organization running log)			
(8) how well bottom plugged			
DRILLERS REMARKS:			


RECEIVED

SEP 10 1977

MISS. RD. OF WATER COMMISSIONERS

If well telescopes please sketch and show depths.

GROUND LEVEL

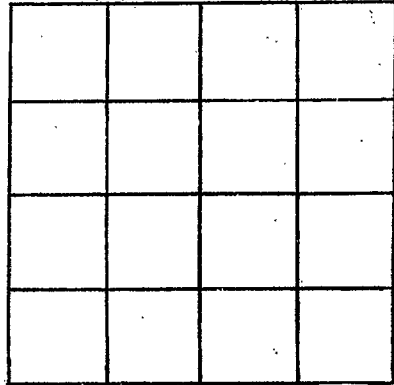

SECTION \_\_\_\_\_

Please indicate well location X.

ADDITIONAL INFORMATION

If more than one screen,  
show locations of each on sketch.