

WAYNE
G 2016
8-5-77

MISSISSIPPI
BOARD OF WATER COMMISSIONERS
416 North State Street
Jackson, Mississippi 39201

13P

WATER WELL DRILLERS LOG

McILWAIN WATER WELL SERVICE Wayne

Aug 5 1977 date well completed
firm name 31
county well located

LANDOWNER:
Bobby Edison
Waynesboro Miss
(mailing address)

WELL LOCATION:
sec. 20 T. 9 N R. 8 E
3 miles NW of Whittier
(distance) (direction) (nearest town)

WELL PURPOSE: Home
(home, irrigation, municipal, industrial)

WELL COMPLETION DATA:
(1) diameter (inches) 2"
(2) total depth (feet) 165'
(3) static water level (feet) 69' below above top of ground.
(4) casing PVC 160' (material) (depth)
2" if telescope see back. (size)
(5) screen 5' 160' (length) (depth to top)
1 1/4" Stainless Steel (size) (material)
(6) pump 1 8 (HP) (yield gpm)
220 AC (type power)
(7) electric log No (yes or no)
(organization running log)
(8) how well bottom plugged

description of formations encountered	from	to
Red sandy Clay	0	12
Sand	12	28
Clay	28	38
Fine Sand	38	50
Med. Sand	50	63
Clay	63	88
Red Sand	88	102
Clay	102	140
Fine Sand	140	150
Med. Sand	150	165


DRILLERS REMARKS:

RECEIVED
SEP 19 1977

MISS. Bd. OF WATER COMMISSIONERS

If well telescopes please sketch and show depths.

GROUND LEVEL

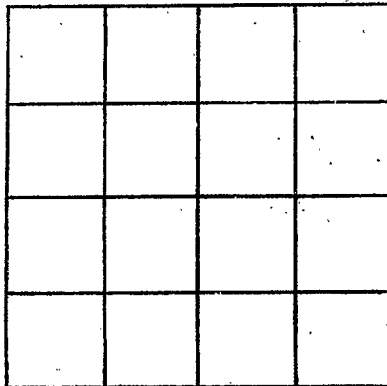

SECTION _____

Please indicate well location X.

ADDITIONAL INFORMATION

If more than one screen, show locations of each on sketch.