

WAYNE
 G 2017
 4-8-78

MISSISSIPPI
 BOARD OF WATER COMMISSIONERS
 416 North State Street
 Jackson, Mississippi 39201

WATER WELL DRILLERS LOG
 McILWAIN WATER WELL SERVICE

April 8 1978 date well completed
 RT # BOX 32 firm name
 WAYNESBORO, MISS. 39367
 Wayne county well located

LANDOWNER:
 Billy Ray Cobley
 Waynesboro Miss.
 (mailing address)

description of formations encountered	from to	
Red Clay	0	15
Coarse Sand	15	51

WELL LOCATION:
 sec. 12 T 9 N R 8 E
 S W
 8 miles NW of Wboro
 (distance) (direction) (nearest town)

WELL PURPOSE: Home
 (home, irrigation, municipal, industrial)


- WELL COMPLETION DATA:
- diameter (inches) 2"
 - total depth (feet) 51'
 - static water level (feet) 37' below above top of ground.
 - casing PVC 46' (material) (depth)
 2" (size) if telescope see back.
 - screen 5' 46' (length) (depth to top)
 2" PVC, 008 (size) (material)
 - pump 1 9 (HP) (yield gpm)
 220 AC (type power)
 - electric log NO (yes or no)
- (organization running log)
- (8) how well bottom plugged

DRILLERS REMARKS:

RECEIVED
 APR 24 1978
 MISS. BD OF WATER COMMISSIONERS

If well telescopes please sketch and show depths.

GROUND LEVEL

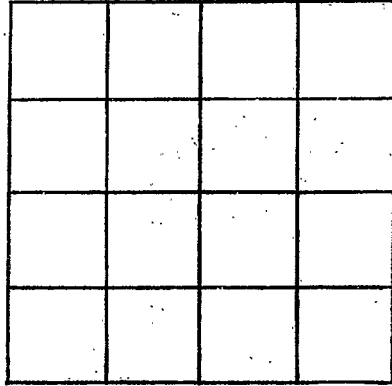

SECCIÓN _____

Please indicate well location X.

ADDITIONAL INFORMATION

If more than one screen,
show locations of each on sketch.