


WAYNE
G. 2020
11-20-78

**MISSISSIPPI
BOARD OF WATER COMMISSIONERS**
416 North State Street
Jackson, Mississippi 39201

WATER WELL DRILLERS LOG


Nov. 20 1978 McILWAIN WATER WELL SERVICE Wayne
 date well completed RT. # 10 BOX 37 county well located
 MISS. 20267

LANDOWNER:	description of formations encountered	from	to
<u>John Riles</u>			
<u>Waynesboro, Miss.</u> (mailing address)	<u>Gravel, Sand, + Clay</u>	<u>5</u>	<u>10</u>
WELL LOCATION: sec. <u>23</u> T. <u>9</u> N R. <u>8</u> W <u>4</u> miles <u>NE</u> of <u>Whistler</u> (distance) (direction) (nearest town)	<u>Clay</u>	<u>10</u>	<u>15</u>
WELL PURPOSE: <u>Home</u> (home, irrigation, municipal, industrial)	<u>Sand + Clay</u>	<u>15</u>	<u>31</u>
WELL COMPLETION DATA: (1) diameter (inches) <u>2"</u>	<u>Clay</u>	<u>31</u>	<u>32</u>
(2) total depth (feet) <u>44</u>	<u>Sand</u>	<u>32</u>	<u>34</u>
(3) static water level (feet) <u>23'</u> below top of ground.	<u>Clay</u>	<u>34</u>	<u>35</u>
(4) casing <u>PVC</u> , <u>39'</u> (material) (depth) <u>2"</u> (size) If telescope see back.	<u>Sand</u>	<u>35</u>	<u>44</u>
(5) screen <u>5'</u> , <u>39'</u> (length) (depth to top) <u>2"</u> , <u>PVC</u> , <u>.008</u> (size) (material)			
(6) pump <u>1/2</u> , <u>8</u> (HP) (yield gpm) <u>110 AC</u> (type power)			
(7) electric log <u>No</u> (yes or no) (organization running log)			
(8) how well bottom plugged			
DRILLERS REMARKS:			

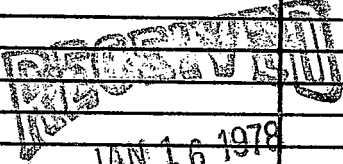
 JAN 16 1978
 MISS. BD. OF WATER COMMISSIONERS

If well telescopes please sketch and show depths.

GROUND LEVEL

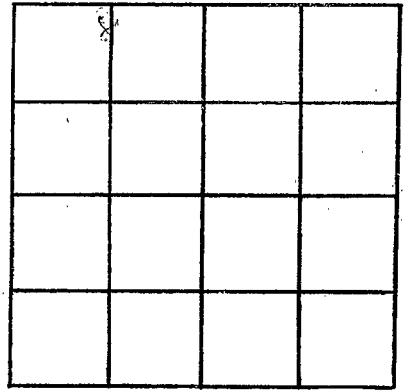

SECTION _____

Please indicate well location X.

ADDITIONAL INFORMATION

If more than one screen,
show locations of each on sketch.