

WAYNE
 G 202
 1-11-79

MISSISSIPPI
 BOARD OF WATER COMMISSIONERS
 416 North State Street
 Jackson, Mississippi 39201

WATER WELL DRILLERS LOG


JAN 11 1979 MAILWAIN WATER WELL SERVICE WAYNE
 date well completed RT. 2 firm BOX 37 county well located
 WAYNESBORO, MISS. 39367

LANDOWNER:	description of formations encountered	from	to
HOLLIS CAVERS	Red SAND	0	5
Waynesboro Miss (mailing address)	Red Sandy Clay	5	13
WELL LOCATION: sec. 15 T 4 N R 2 E 11 miles NW of W'boro (distance) (direction) (nearest town)	SAND & Clay	13	20
WELL PURPOSE: HOME (home, irrigation, municipal, industrial)	SAND	20	28
WELL COMPLETION DATA: (1) diameter (inches) 2" (2) total depth (feet) 150' (3) static water level (feet) 61' below top of ground. (4) casing PVC, 125' (material) (depth), 2" (size) If telescope see back. (5) screen NONE, (length) (depth to top) (6) pump 1 (HP), 7 (yield gpm) (7) electric log No (yes or no) (organization running log) (8) how well bottom plugged	SAND & Clay	28	35
	Yellow Clay	35	40
	Blue Clay	40	53
	SAND & Clay	53	68
	Blue Clay	68	75
	Rock	75	76
	Limy Blue Clay	76	78
	Brown Clay	78	125
	Honey Comb Rock	125	150

DRILLERS REMARKS:
 Miss. Board of Water Comm.
 MAR 5 - 1979
 RECEIVED

If well telescopes please sketch and show depths.

GROUND LEVEL

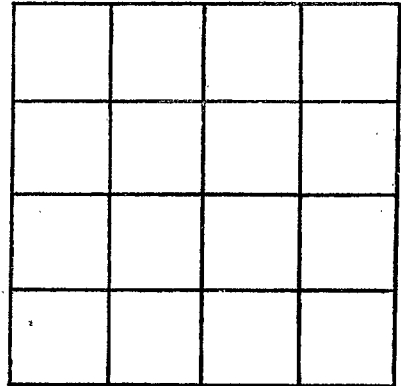

SECTION _____

Please indicate well location X.

ADDITIONAL INFORMATION

If more than one screen,
show locations of each on sketch.