

Wayne  
G. Hall  
6-2-79

MISSISSIPPI  
BOARD OF WATER COMMISSIONERS  
416 North State Street  
Jackson, Mississippi 39201

WATER WELL DRILLERS LOG

June 2 1979 Proctor Drilling Wayne  
date well completed firm name county well located

LANDOWNER: Bill Hall

description of formations encountered

from to

Box 7 Hargrave Drive  
(mailing address)

WELL LOCATION:

sec 22 T 9 N R 2 E  
S W  
2 miles NW of Hargrave  
(distance) (direction) (nearest town)

WELL PURPOSE: Home  
(home, irrigation, municipal, industrial)

WELL COMPLETION DATA:

- (1) diameter (inches) 2"  
(2) total depth (feet) 195'  
(3) static water level (feet) 74' (below/above top of ground)

(4) casing galv 170'  
(material) (depth)  
2" If telescope see back.  
(size)

(5) screen none  
(length) (depth to top)  
(size) (material)

(6) pump 2 2  
(HP) (yield gpm)  
elec  
(type power)

(7) electric log no  
(yes or no)  
(organization running log)

(8) how well bottom plugged  
open

DRILLERS REMARKS:

red sand	0	39
sand	39	40
sand & clay	40	60
sand	60	65
sand & clay	65	78
blue clay	78	93
rock strata	93	125
clay	125	131
sand & gravel - coarse	131	162
blue clay	162	170
Hechberg	170	195

105' 1 1/4" galv  
drug pipe


Miss. Board of Water Comm'rs

JUN 10 1979

Wayne

If well telescopes please sketch and show depths.

GROUND LEVEL

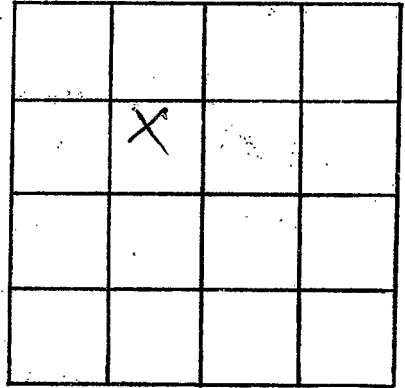

SECTION 22

Please indicate well location X.

ADDITIONAL INFORMATION

If more than one screen,  
show locations of each on sketch.