

Wayne
 G 2027
 11-19-79

MISSISSIPPI
 BOARD OF WATER COMMISSIONERS
 416 North State Street
 Jackson, Mississippi 39201

WATER WELL DRILLERS LOG

Nov 19 1979 Boyer Drilling, Inc. Itawamba
 date well completed firm name county well located

LANDOWNER: Mr. Lott
Boyer
At 1 Haynesboro Miss
 (mailing address)

| description of formations encountered | from | to |
|---------------------------------------|------|-----|
| Clay | 0 | 20 |
| sandy clay | 20 | 62 |
| clay | 62 | 80 |
| fine sand | 80 | 90 |
| buff coarse sand | 90 | 100 |
| stagnant clay | | |

WELL LOCATION:
 sec 33 T 9 (N) R 8 E
1 miles N of Huber
 (distance) (direction) (nearest town)

WELL PURPOSE: Domestic
 (home, irrigation, municipal, industrial)

88' 1" PVC deep pipe

- WELL COMPLETION DATA:
- (1) diameter (inches) 2"
 - (2) total depth (feet) 100'
 - (3) static water level (feet) 66' below top of ground.
 - (4) casing PVC 95'
 (material) (depth)
2" If telescope see back.
 (size)
 - (5) screen 5' 95'
 (length) (depth to top)
2" sch 50
 (size) (material)
 - (6) pump 1 5
 (HP) (yield gpm)
elec.
 (type power)
 - (7) electric log no
 (yes or no)

(organization running log)

(8) how well bottom plugged
2" backwash valve

DRILLERS REMARKS:
shell trap above screen


DEPT. OF NATURAL RESOURCES
 BUREAU OF LAND & WATER RESOURCES

DEC 13 1979

RECEIVED

If well telescopes please sketch and show depths.

GROUND LEVEL

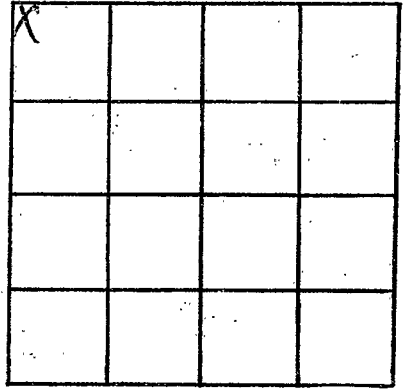

SECTION 33

Please indicate well location X.

ADDITIONAL INFORMATION

If more than one screen, show locations of each on sketch.