

WAYNE

5 2028

2/28/80

MISSISSIPPI BOARD OF WATER COMMISSIONERS 416 North State Street Jackson, Mississippi 39201

WATER WELL DRILLERS LOG

Feb 28

date well completed

1980 Porter Drilling, Inc

firm name

Wayne

county well located

LANDOWNER: Yvonne Poolay

Box 1 Hubert, Miss

(mailing address)

WELL LOCATION:

sec. 4 T 9 N R 8 E 4 miles east of Circula

WELL PURPOSE: Home (home, irrigation, municipal, industrial)

WELL COMPLETION DATA:

- (1) diameter (inches) 2"
(2) total depth (feet) 72
(3) static water level (feet) 53 below top of ground
(4) casing P.V.C. 67' (material) (depth)
(5) screen 5' 67' (length) (depth to top)
(6) pump 1 10 (HP) (yield gpm)
(7) electric log no (yes or no)

(organization running log)

(8) how well bottom plugged

2" sand shank

DRILLERS REMARKS:

shell trap above screen 62' 1" P.V.C. drop pipe

description of formations encountered

from to

Table with 3 columns: description of formations encountered, from, to. Rows include: Clay (0-10), sand (10-20), clay & sand (20-30), sand (30-60), clay & sand (60-67), coarse sand (67-72), stop on clay.


DEPT. OF NATURAL RESOURCES BUREAU OF LAND & WATER RESOURCES

MAR 18 1980

RECEIVED

If well telescopes please sketch and show depths.

GROUND LEVEL

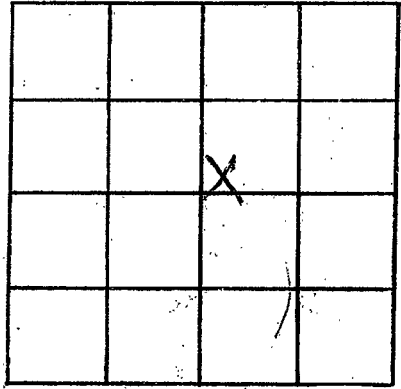

SECTION 4

Please indicate well location X.

ADDITIONAL INFORMATION

If more than one screen, show locations of each on sketch.