

Wayne
 G. 2008
 5-13-80

MISSISSIPPI
 BOARD OF WATER COMMISSIONERS
 416 North State Street
 Jackson, Mississippi 39201

WATER WELL DRILLERS LOG

April 24 1980 Robert D. Williams, Inc. Wayne
 date well completed firm name county well located

LANDOWNER: <u>Barbara May</u>	description of formations encountered	from	to
<u>841 Shubuta Miss</u>	Clay	0	9
	thin sand		9
(mailing address)	sand	9	21
WELL LOCATION:	Clay	21	53
sec. <u>7</u> T <u>9</u> N. <u>10</u> R. <u>8</u> E	sandstone clay	53	60
<u>9</u> miles <u>NW</u> of <u>Shubuta</u>	sandstone	60	67
(distance) (direction) (nearest town)	Clay	67	72
WELL PURPOSE: <u>drinking</u> (home, irrigation, municipal, industrial)			
WELL COMPLETION DATA:	<u>42" 1" PVC discharge</u>		<u>0 00</u>
(1) diameter (inches) <u>2"</u>			
(2) total depth (feet) <u>67</u>			
(3) static water level (feet) <u>34</u> (below/above top of ground)			
(4) casing <u>PVC</u> , <u>62'</u> (material) (depth)			
<u>2"</u> (size) if telescope see back.			
(5) screen <u>5</u> , <u>62'</u> (length) (depth to top)			
<u>2"</u> , <u>62' x 5.5</u> (size) (material)			
(6) pump <u>1</u> , <u>12</u> (HP) (yield gpm)			
<u>elec</u> (type power)			
(7) electric log <u>none</u> (yes or no)			
(organization running log)			
(8) how well bottom plugged <u>not plugged</u>			
DRILLERS REMARKS:			


DEPT. OF NATURAL RESOURCES
 BUREAU OF LAND & WATER RESOURCES

MAY 12 1980

RECEIVED

If well telescopes please sketch and show depths.

GROUND LEVEL

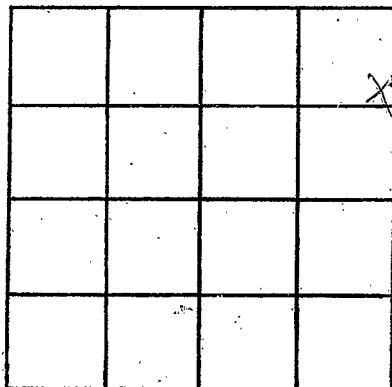

SECTION 17

Please indicate well location X.

ADDITIONAL INFORMATION

If more than one screen,
show locations of each on sketch.