

MISSISSIPPI DEPARTMENT OF NATURAL RESOURCES

Bureau of Land and Water Resources

Southport Mall

P.O. Box 10631

Jackson, Mississippi 39209

WATER WELL DRILLERS LOG

Wayne
G 2030
8-14-80

Aug 14 1980 Booster Drilling, Inc. 21 Wayne
 date well completed firm name county well located

LANDOWNER: <u>George Reynolds</u> <u>At 1</u>	description of formations encountered	from	to
<u>Shulata Miss</u> (mailing address)	<u>sand</u>	<u>0</u>	<u>69</u>
WELL LOCATION: sec <u>3</u> T <u>9</u> N R <u>8</u> E W	<u>sand some clay</u>	<u>69</u>	<u>75</u>
<u>8</u> miles <u>N.W. Haynesboro</u> (distance) (direction) of (nearest town)	<u>Coarse sand & clay</u>	<u>75</u>	<u>78</u>
WELL PURPOSE: <u>home</u> (home, irrigation, municipal, industrial)			
WELL COMPLETION DATA:			
(1) diameter (inches) <u>2"</u>			
(2) total depth (feet) <u>75'</u>			
(3) static water level (feet) <u>55'</u> <u>below</u> <u>above</u> top of ground.			
(4) casing <u>PVC</u> <u>70'</u> (material) (depth) <u>2'</u> (size) if telescope see back.			
(5) screen <u>5'</u> <u>70'</u> (length) (depth to top) <u>2'</u> <u>60' S.S.</u> (size) (material)			
(6) pump <u>1</u> <u>10</u> (HP) (yield gpm) <u>elec.</u> (type power)			
(7) electric log <u>no</u> (yes or no) (organization running log)			
(8) how well bottom plugged <u>2' sand shale</u>			


DRILLERS REMARKS:

DEPT. OF NATURAL RESOURCES
 BUREAU OF LAND & WATER RESOURCES

SEP 24 1980
 RECEIVED

If well telescopes please sketch and show depths.

GROUND LEVEL

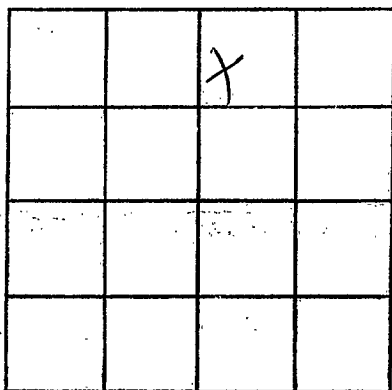

SECTION 3

Please indicate well location X.

ADDITIONAL INFORMATION

If more than one screen,
show locations of each on sketch.