

WAYNE

G 2031

6/81

MISSISSIPPI BOARD OF WATER COMMISSIONERS
416 North State Street
Jackson, Mississippi 39201

WATER WELL DRILLERS LOG

date well completed 1981 Roy V. West Drig firm name Wayne county well located

LANDOWNER:

Anthony Boyles
Rt 1 Waynesboro
(mailing address)

description of formations encountered

from to

CLAY	0	40
SAND	40	63
CLAY	63	90
SAND	90	121

WELL LOCATION:

sec. 32 T 9 N R 8 E
15 miles W of Waynesboro
(distance) (direction) (nearest town)

WELL PURPOSE: HOME
(home, irrigation, municipal, industrial)

WELL COMPLETION DATA:

- (1) diameter (inches) 4"
- (2) total depth (feet) 121'
- (3) static water level (feet) 40' ^{below} / _{above} top of ground.
- (4) casing PVC, 111'
(material) (depth)
(size) if telescope see back.
- (5) screen 10', 111'
(length) (depth to top)
2", PVC
(size) (material)
- (6) pump _____ (HP) _____ (yield gpm)
REA
(type power)
- (7) electric log no
(yes or no)
(organization running log)
- (8) how well bottom plugged WASH VALVE


DRILLERS REMARKS:

DEPT. OF NATURAL RESOURCES
BUREAU OF LAND & WATER RESOURCES

JUN 17 1981
RECEIVED

If well telescopes please sketch and show depths.

GROUND LEVEL

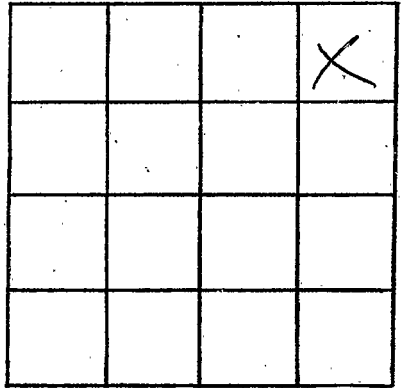

SECTION 32

Please indicate well location X.

ADDITIONAL INFORMATION

If more than one screen, show locations of each on sketch.