

Wayne
G 2033
8-19-81

MISSISSIPPI
BOARD OF WATER COMMISSIONERS
416 North State Street
Jackson, Mississippi 39201

WATER WELL DRILLERS LOG

August 19 1981 Roy U. West Dely Inc. Wayne
date well completed firm name county well located

LANDOWNER:	description of formations encountered	from	to
Dennis Boyles			
Waynesboro	SANDY CLAY	4	31
(mailing address)	SAND	31	150

WELL LOCATION:
sec. 28 T. 9 N R. 8 E
S W
10 miles NW of Waynesboro
(distance) (direction) (nearest town)

WELL PURPOSE: ~~farm~~ farm
(home, irrigation, municipal, industrial)


- WELL COMPLETION DATA:
- (1) diameter (inches) 4"
 - (2) total depth (feet) 150'
 - (3) static water level (feet) 43' below top of ground.
 - (4) casing PVC, 140'
(material) (depth)
(size) if telescope see back.
 - (5) screen 10', 140'
(length) (depth to top)
4" PVC
(size) (material)
 - (6) pump 1, 20
(HP) (yield gpm)
REA
(type power)
 - (7) electric log no
(yes or no)
(organization running log)
 - (8) how well bottom plugged
WASH VALVE

DRILLERS REMARKS:

DEPT. OF NATURAL RESOURCES
BUREAU OF LAND & WATER RESOURCES
NOV 10 1981
RECEIVED

If well telescopes please sketch and show depths.

GROUND LEVEL

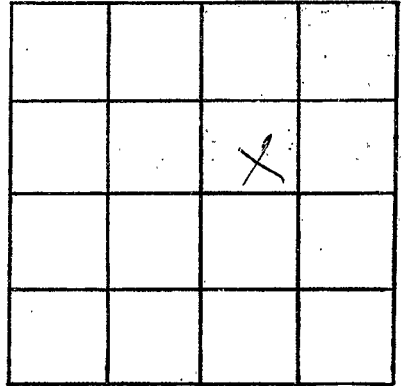

SECTION 28

Please indicate well location X.

ADDITIONAL INFORMATION

If more than one screen,
show locations of each on sketch.