

Wayne  
G 2034

MISSISSIPPI  
BOARD OF WATER COMMISSIONERS  
416 North State Street  
Jackson, Mississippi 39201

WATER WELL DRILLERS LOG

Jan 14 1982 Roy K. West Drllg Wayne  
date well completed firm name county well located

LANDOWNER:	description of formations encountered	from	to
Albert Smith			
R+1 Box 288	SAND	8	92
WAYNESBORO (mailing address)	GRAVEL	92	120
	SAND	120	130

WELL LOCATION:  
sec. 11 T. 9 N. R. 8 E  
12 miles NW of WAYNESBORO  
(distance) (direction) (nearest town)

WELL PURPOSE: HOME  
(home, irrigation, municipal, industrial)

- WELL COMPLETION DATA:
- (1) diameter (inches) 7"
  - (2) total depth (feet) 130'
  - (3) static water level (feet) 70' below top of ground.
  - (4) casing PVC, 124' (material) (depth)  
(size) If telescope see back.
  - (5) screen 6' 124' (length) (depth to top)  
1/4" STAINLESS STEEL (size) (material)
  - (6) pump 1 (HP) 6 (yield gpm)  
RED (type power)
  - (7) electric log NO (yes or no)  
(organization running log)
  - (8) how well bottom plugged W P S V H L V K


DRILLERS REMARKS:

DEPT. OF NATURAL RESOURCES  
BUREAU OF LAND & WATER RESOURCES

FEB 10 1982  
RECEIVED

If well telescopes please sketch and show depths.

GROUND LEVEL

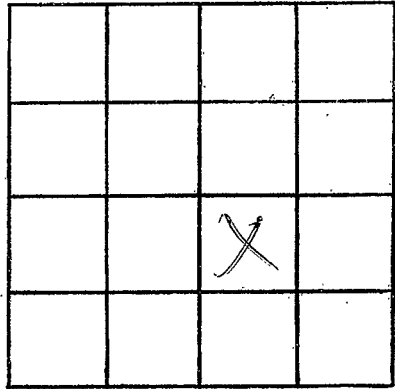

SECTION 11

Please indicate well location X.

ADDITIONAL INFORMATION

If more than one screen, show locations of each on sketch.