

MISSISSIPPI DEPARTMENT OF NATURAL RESOURCES

Bureau of Land and Water Resources

Southport Mall

P.O. Box 10631

Jackson, Mississippi 39209

WATER WELL DRILLERS LOG

Wayne
G 2036
5-21-85

2

May 21 1985
date well completed

Pointe Drilling & Pump
firm name

Wayne
county well located

LANDOWNER: Kevin Nail
Box 1 Box 250
Waynesboro Ms.
(mailing address)

description of formations encountered

from to

WELL LOCATION:
sec. 15 T-9 N R-8 E
8 miles NW of Waynesboro
(distance) (direction) (nearest town)

red clay	0	9
blue clay	9	20
thin rocks		20
blue	20	34
red strata	34	50
soft sand & clay	50	54
blue	54	85
thin blue rocks	85	105
white clay & soft rocks	105	120

WELL PURPOSE: none
(home, irrigation, municipal, industrial)

- WELL COMPLETION DATA:
- diameter (inches) 2"
 - total depth (feet) 120'
 - static water level (feet) 23' (below above top of ground)
 - casing galv. (material) 85' (depth)
2" (size) if telescope see back.
 - screen none used (length) (depth to top)
(size) (material)
 - pump 1 (HP) 8 (yield gpm)
(type power)
 - electric log no (yes or no)
(organization running log)
 - how well bottom plugged open

63' 1/2" galv. iron pipe


RECEIVED
JUL 23 1985

DRILLERS REMARKS:

Department of Natural Resources
Bureau of Land & Water Resources

If well telescopes please sketch and show depths.

GROUND LEVEL

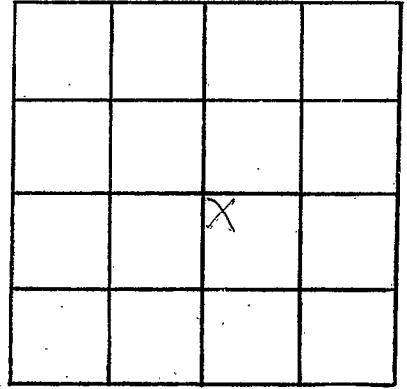

SECTION 15

Please indicate well location X.

ADDITIONAL INFORMATION

If more than one screen,
show locations of each on sketch.